


Graham ~~KANSAS~~Section 2 Township 10 Range 21WWell No. #3 McClellanCompany Jones-Shelburne & Farmer

NORTH

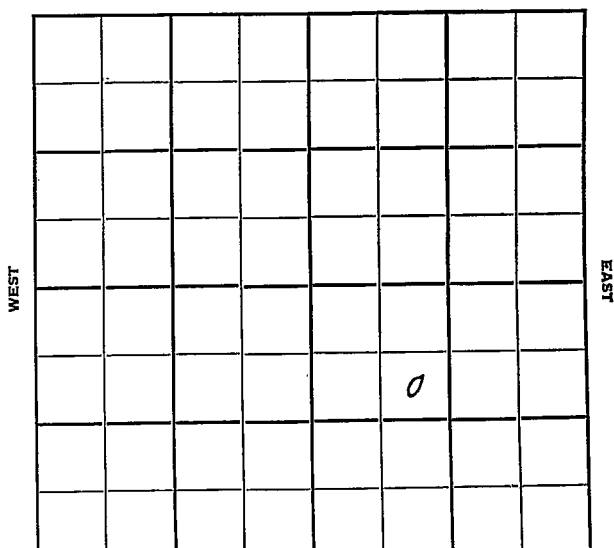

SOUTH

Sec. 2 Twp. 10 R. 21W ✓

Well No. #3 McClellan Farm

Jones-Shelburne & Farmer Company

Contractor

Cooper


990 Ft. from N. Line

Ft. from S. Line

990 Ft. from E. Line

990 Ft. from W. Line

SE NW SE

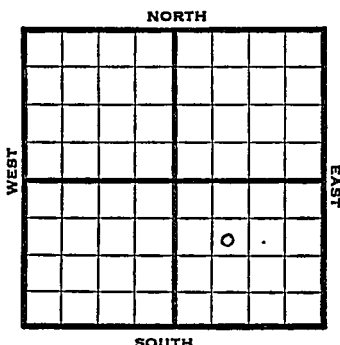

1951

Elev. 2270' REPORT

11/7

Spud-10-28-51

8" @ 152'

Anhy 1730-80

Drlg. 3555'

12/5

Spud 10-28-51

Oil well TD 3795

8" @ 152

Anhy 1730-80 Heeb. 3461

KC 3502 Arb. 3786-90

5" @ 3790 TD 3795

S/ 18 BOPH 14 hr. 1000 A

S/ 60 BOPH

Comp. 381 BOPD

COMPLETED

County Graham State Kansas

Sec. **2** (Blk. **10** (Sur. **21W** Map No.

Operator **Jones-Shelburne & Farmer**

Well No. **3** Farm **Mc Clellan**

Elev. 2270 Location SE NW SE

FIRST REPORT

990 Ft. From N Line SE

990 Ft. From **IV** Line Quarter

1st. Report **NOV 7 1951**

Completion

Remarks


Spudding Date **10-28-51**

Drig. Data Cooper

8" @ 152 Anhy 1730-80 Drlg. 3555

J. E. TYRA

County Graham State Kansas
 Sec. 2 (Blk.) 10 (Sur.) 2 1W Map No.
 Operator Jones, Shelborne & Farmer
 Well No. 3 Farm McClellan
 Elev. 2270 Location SE NW SE

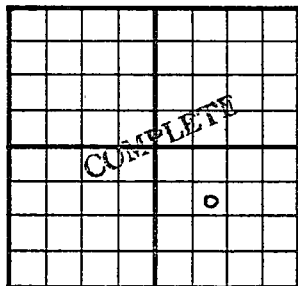

990 Ft. From N Line SE
990 Ft. From W Line Quarter
 1st. Report
 Completion DEC 5 1951
 Remarks Cooper Pool

Spudding Date 10-28-51

Drilg. Data Oil well TD 3795
8" @ 152 Anhy 1730-80 Heeb. 3461
KC 3502 Arb. 3786-90 5" @ 3790
TD 3795 S/ 18 boph 14 hr. 1000 A
S/ 60 boph Comp. 381 bopd

J. E. TYRA