


Section 2 Township 10 Range 21 W

KANSAS

Well No. # 5 McClellan

Company Jones, Shelborne & Farmer

NORTH

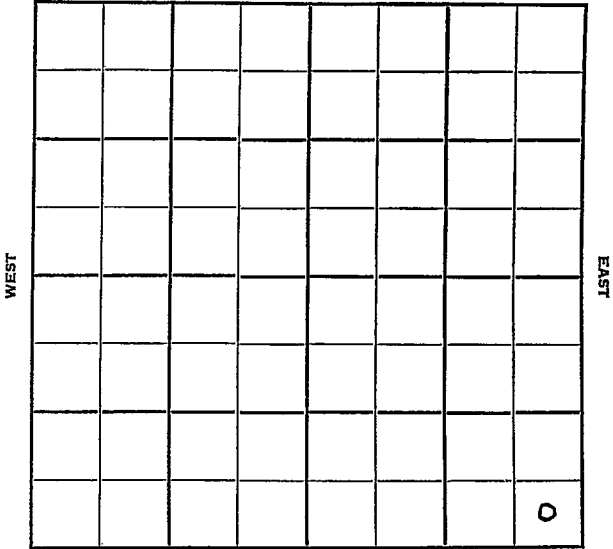

SOUTH

WEST

EAST

Sec. 2 Twp. 10 R. 21W

Well No. #5 McClellan Farm

Jones, Shelborne & Farmer Company

Contractor


\_\_\_\_\_ Ft. from N. Line

330' Ft. from S. Line

330' Ft. from E. Line

\_\_\_\_\_ Ft. from W. Line

SE SE SE

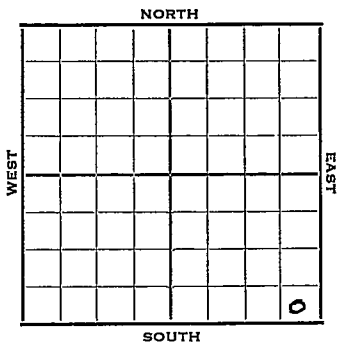

1952 Elev. 2275' REPORT

3/12 Surface set

3/19 "

3/25 MIR

4/1 8" @ 155'

Anhy 1846

Drlg. 3160'

4/9 Heeb. 3500 Tor. 3524

Lans. 3538

DST 3572-86, 1 hr. 45' muddy SW  
180' SW 1020#

DST 3620-29, 1 hr. 125' muddy  
SW, 990#

DST 3721-34, 1 hr. 25' m 510#  
B KC 3759 Marm li 3774

Marm chert 3807 Arb. 3831

RTD 3835

5" @ 3832' WOC

4/23 CO DD to 3838' Test 2 gal OPH  
1500 A Test 1 BOPH To A

4/30 2000 A Tes 3 BOPH Tub & Rods

5/7 NR

5/14 NR

5/21 "

5/28 NR

OVER

1952

6/4 Spud 3-24-52  
Oil Well TD 3838  
8" @ 155  
Anhy 1846 Heeb. 3500  
Tor. 3524 Lans. 3538  
DST 3572-86 opa 1 hr. Rec. 45' muddy  
sw 180' sw  
DST 3620-29 opa 1 hr. Rec. 125' muddy  
sw DST 3721-34 opa 1 hr. Rec. 25'  
mud BKC 3759 Marm. lime 3774  
Marm. ch 3807 Arb. 3831  
TD 3835 5" @ 3832 DD 3838  
2 goph 1500 A 1 boph 2000 A  
3 boph Comp. 84 bopd

**COMPLETED**



County Graham State Kansas  
 Sec. 2 (Blk.) 10 (Sur.) 21W Map No.  
 Operator Jones, Shelborne & Farmer  
 Well No. 5 Farm McClellan  
 Elev. 2275 Location SE SE SE

					0

**COMPLETE**

330 Ft. From S Line SE  
330 Ft. From E Line Quarter  
 Ist. Report \_\_\_\_\_  
 Completion JUN 4 1952  
 Remarks \_\_\_\_\_  
 Spudding Date 3-24-52

Drlg. Data Oil well TD 3838  
8" @ 155 Anhy 1846 Heeb. 3500  
Tor. 3524 Lans. 3538 DST 3572-86  
open 1 hr. Rec. 45' muddy sw 180' sw  
DST 3620-29 open 1 hr. Rec. 125' muddy  
sw DST 3721-34 open 1 hr. Rec. 25' mud  
B KC 3759 Marm. lime 3774 Marm. ch. 3807  
Arb. 3831 TD 3835 5" @ 3832 DD 3838  
2 goph 1500 A 1 boph 2000 A.  
3 boph Comp. 84 bopd