


Section 2 Township 10 Range 21W

Well No. #6 McClellan

Company Jone, Shelburne & Farmer

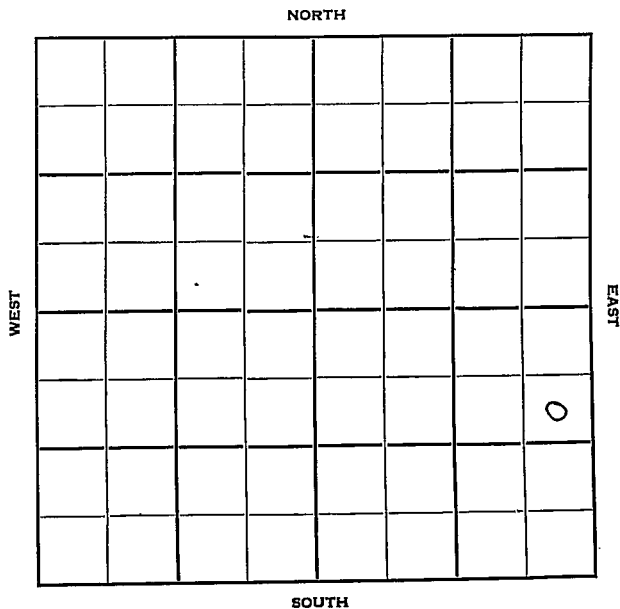

Graham

KANSAS

Sec. 2 Twp. 10 R. 21W

Well No. #6 McClellan Farm

Jones, Shelburne & Farmer Company

J-S-F Contractor

Cooper Pool


990 Ft. from N. Line

 Ft. from S. Line

330 Ft. from E. Line

 Ft. from W. Line

SE NE SE

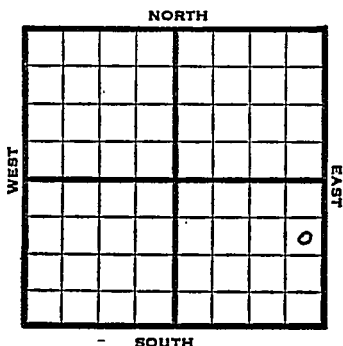

1952 Elev. 2283' REPORT

10/1 Spud 9-24-52
8" @ 150 Anhy 1752
Drlg. 3135

10/8 Toronto 3512, Lans 3527, Arb.
3814-18 TD
5" @ 3815, WOC

10/15 Drlg. deeper 3833, 1500A, POP


10/22 DD 3839' 1500A S/25 BOPH

10/29 NR

11/5 Spud 9-24-52
Oil Well TD 3839' 8" @ 150
Anhy 1752 Tor. 3512
Lans. 3527 Arb. 3814
TD 3818 5" @ 3815 CO to 3818
B/ 30 goph DD 3827 S/ 1½ boph
1000 A S/ 9 boph DD 3833
1500 A DD 3839 1500 A S/ 25 boph
Comp. 365 bopd

COMPLETED


County Graham State Kansas
 Sec. 2 (Blk.) 10 (Sur.) 21W Map No.
 (Twp.)
 Operator Jones, Shelburne & Farmer
 Well No. 6 Farm McClellan
 Elev. Location SE NE SE

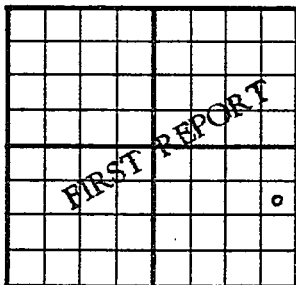

990 Ft. From N Line SE
330 Ft. From E Line Quarter
 1st. Report OCT 1 1952
 Completion
 Remarks
J-S-F - Contr.
 Spudding Date 9-24-52

Drlg. Data Cooper Pool
8" @ 150 Anhy 1752 drlg. 3135

J. G. McGEHEE

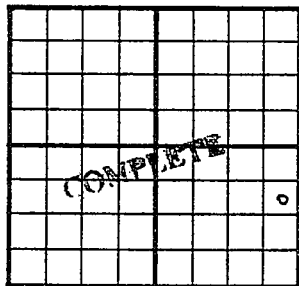County Graham State KansasSec. 2 (Blk.) 10 (Sur.) 21W Map No.Operator Jones, Shelburne & FarmerWell No. 6 Farm McClellanElev. 2283 Location SE NE SE990 Ft. From N Line SE330 Ft. From E Line Quarter

1st. Report

Completion NOV 5 1952Remarks Cooper PoolJ-S-F - Contr.Spudding Date 9-24-52Drlg. Data Oil well TD 38398" @ 150 Anhy 1752 Tor. 3512Lans. 3527 Arb. 3814 TD 38185" @ 3815 CD to 3818 B/ 30 gophDD 3827 S/ $1\frac{1}{2}$ boph 1000 A S/ 9 bophDD 3833 1500 A DD 3839 1500 AS/ 25 boph Comp. 365 bopd