

Section 2 Township 10 Range 21W

Well No. #6 Noah

Company Phillips Pet.

NORTH

		0					

WEST

EAST

SOUTH

Sec. 2 Twp. 10 R. 21W ✓

Well No. #6 Noah Farm

Phillips Pet. Company

Phillips Pet. - Contr. Contractor

Cooper Pool


_____ Ft. from N. Line

990' Ft. from S. Line

990' Ft. from E. Line

_____ Ft. from W. Line

NW SE NW

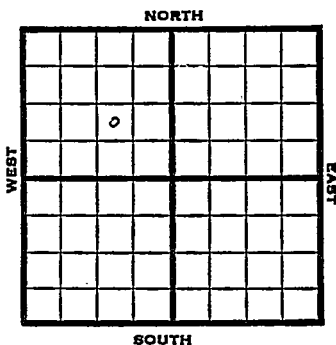

1951

Elev. 2262' REPORT

4/11

Cellar & Pits

5/2

Spud 4-12-51

D & A TD 3920'

Anhy 1738', 8" @ 1782' Heeb 3473'

Tor. 3496', Lans 3518' Arb 3857'

TD 3920'

DST 3528-68' open 1 hr. rec 45' mud

DST 3584-3624 open 1 hr. rec 40' mud

& water

D & A

ABANDONED

