

Section 2 Township 10 Range 21W

Well No. #7 Noah

Company Phillips Pet.

NORTH

		0					

WEST

EAST

SOUTH

Graham

KANSAS

Sec. 2 Twp. 10 R. 21W

Well No. #7 Noah Farm

Phillips Pet. Company

Phillips Pet. Contractor

Cooper Pool


330 Ft. from N. Line

_____ Ft. from S. Line

990 Ft. from E. Line

_____ Ft. from W. Line

NW NE NW

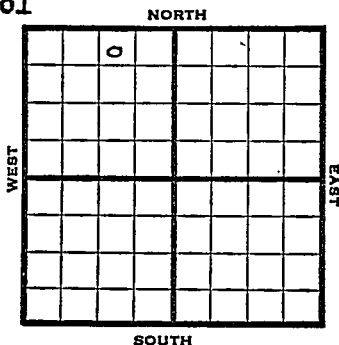

1952

Elev. 2284' REPORT

1/2 Spud 12-30-51
8" @ 319'

1/16 Spud 12-30-51
D&A TD 4065'
8" @ 319

Howard 3282

Top. 3318

Heeb. 3500

Lans. 3541

DST 3542-96 open 1/2 hr. rec. 30' SOCM

B KC 3772

Marm. 3788

Cong. 3846

Arb. 4031

TD 4065 D&A

ABANDONED

County Graham State Kansas

Sec. 2 (Blk. Twp.) 10 (Sur. Rge.) 21W Map No.

Operator Phillips Pet.

Well No. 7 Farm Noah

Elev. _____ Location NW NE NW

		0			

530 Ft. From N Line NW

990 Ft. From E Line Quarter

1st. Report JAN 2 1952

Completion _____

Remarks _____

Phillips Pet. - Contr.

Spudding Date 12-30-51

Drlg. Data Cooper Pool

8" @ 319

J. E. TYRA

County Graham State Kansas

Sec. 2 (Blk. Twp.) 10 (Sur. Rgs.) 21W Map No.

Operator Phillips Pet.

Well No. 7 Farm Noah

Elev. 2284 Location NW NE NW

ABANDONED

330 Ft. From N Line NW

990 Ft. From E Line Quarter

Ist. Report

Completion JAN 1 6 1952

Remarks Cooper Pool

Phillips Pet. - Contr.

Spudding Date 12-30-51

Drig. Data D & A TD 4065

8" @ 319 Howard 3282 Top. 3318

Heeb. 3500 Lens. 3541 DST 3542-96

open 1/2 hr. Rec. 30' soom B KC 3772

Marm. 3788 Cong. 3846 Arb. 4031

TD 4065 D & A