

KANSAS


Graham

FORM 51 25M 3-49 PETROL

Section 2 Township 10 Range 21-W

Well No. #1 Sutor

Company Jones Shelborn & Farmer

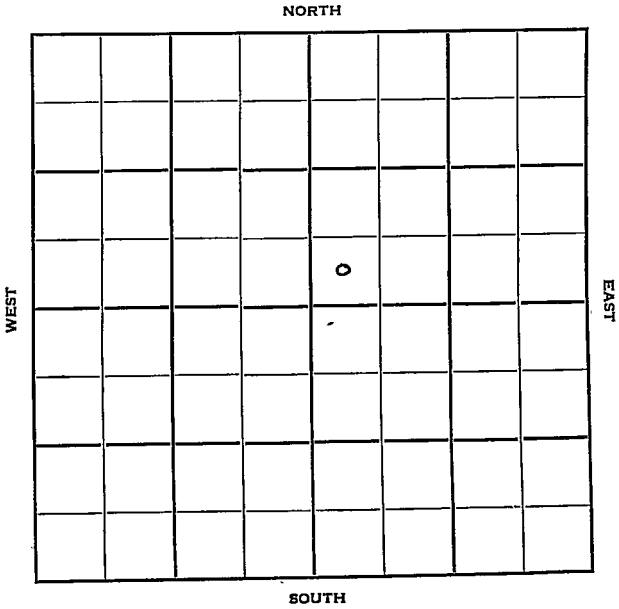

Sec. 2 Twp. 10 R. 21E

Well No. #1 A. Suttor Farm
Jones, Shelborne & Farmer Company
Contractor


330 Ft. from N. Line

310' Ft. from S. Line

330' Ft. from E. Line

330' Ft. from W. Line

SW SW NE

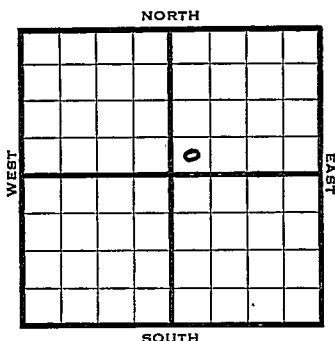

1950

Elev 2287

REPORT

8/23

Spud 8-19-50
8" @ 135'
Anhy 1750'
Dr1g. 1760'

8/23

8 5/8" @ 115
Anhy 1725 Top 3285
Heeb 3492 Lans 3533
DST 3594-3622 opn 15 min rec 500' wtr
DST 3702-20 opn 30 min rec 30' socm
Simp 3832 Arb 3840-44 TD
5" @ 3843
PB 3760
48/3695-3710 10 gal fluid 1/3 oil
2000 A S/5 bfph 75% wtr
D&A

ABANDONED

Map No. _____ Sec. 2 Twp. 10 R. 21WWell No. 1 Sutor _____

Jones Shelborn & Farmer _____ Company

Contractor _____

SW SW NE

SECTION PLAT

FIRST		REPORT	

_____ Ft. from N. Line

330 _____ Ft. from S. Line

_____ Ft. from E. Line

330 _____ Ft. from W. Line

Graham

Skelly DHM

Location _____

Rig up _____

Drilling and Remarks:

Spud 5-26-50

8 5/8 @ 115

Anhy 1725

Drlg. 2370

Stone Phillips Ohio
RECORD

Cased _____ in., _____ ft.

Sand _____

Gas _____

Oil _____

Total Depth _____

PRODUCTION

1st 24 hrs. Nat. _____

1st 24 hrs. after shot _____

Gas _____ Cu. Ft.

Dry Hole _____


Abandoned _____

Date

MAY 31 1950₁₉

J. E. TYRA Scout

County Graham State Kansas
 Sec. 2 (Blk.) 10 (Sur.) 21W Map No.
 Operator Jones, Shelborne & Farmer
 Well No. 1 Farm Sutor
 Elev. 2287 Location SW SW NE

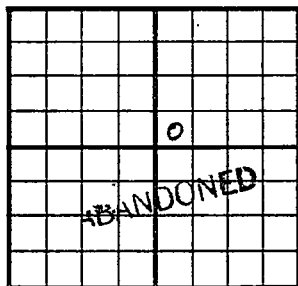

330 Ft. From S Line NE

330 Ft. From W Line Quarter

1st. Report

Completion AUG 23 1950

Remarks

Wildcat

Spudding Date 5-26-50

Drlg. Data D & A TD 3844

8 5/8" @ 115 Anhy 1725 Top. 3285

Heeb. 3492 Lans. 3533 DST 3594-3622

open 15 min. Rec. 500' water DST 3702-20

open 30 min. Rec. 30' socm Simp. 3832

Arb. 3840-44TD 5" @ 3843m PB 3760

48/ 3695-3710 10 gal. fluid 1/3 oil

2000 A S/ 5 bfph 75% water

D & A

J. E. TYRA