


Section 2 Township 10 Range 21-W

Well No. #2 Noah

Company Phillipa Petroleum

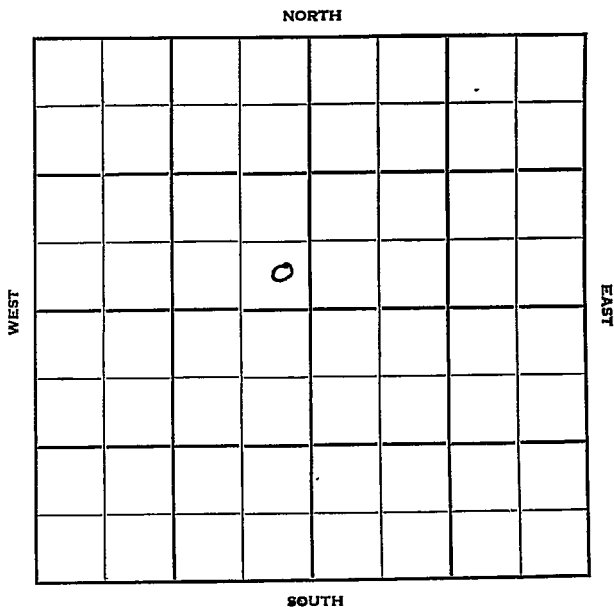

Sec. 2 Twp. 10 R. 21W ✓

Well No. #2 Noah Farm

Phillips Petr. Company

Bass Pool Contractor


_____ Ft. from N. Line

330' Ft. from S. Line

330' Ft. from E. Line

_____ Ft. from W. Line

SE SE NW

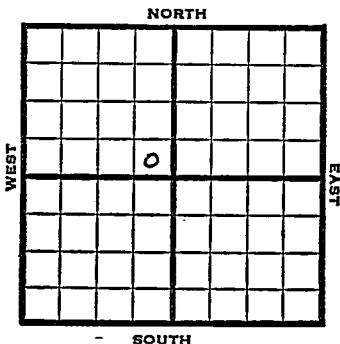

1950

Elev. 2276' REPORT

11/1

Location

1951

1/24

Spud 11-11-50
 Oil Well TD 3840
 Anhy 1740'
 8-5/8" @ 1803' Howard 3269'
 Top. 3297' Heeb. 3473
 Toronto 3498 Lans. 3516'
 BKC 3745' Cong. 3808
 Simp. 3823 Arb. 3826'
 TD 3830 5" @ 3827
 DD 3840 FU 2700' oil 3 hr
 S/42 bo 12 hr 500 A S/207 bo
 7 hr 2000 A P/90 6 hr
 Comp. 3000 bopd

COMPLETED

County Graham State Kansas

Sec. 2 (Blk. 10 (Sur. 21W (Twp. Rge.) Map No.

Operator Phillips Petroleum

Well No. 2 Farm Noah

Elev. 2276 Location SE SE NW

330 Ft. From S Line NW

330 Ft. From E Line Quarter

1st. Report

Completion JAN 24 1951

Remarks Bass Pool

Phillips - Contr.

Spudding Date 11-11-50

COMPLETE.

Drlg. Data Oil well TD 3840

Anhy 1740 8 5/8" @ 1803 Howard 3269

Top. 3297 Heeb. 3473 Toronto 3498

Lans. 3516 B KC 3745 Cong. 3808

Simp. 3823 Arb. 3826 TD 3830 5" @ 3827

DD 3840 FU 2700⁺ oil 3 hr. S/ 42 bo

12 hr. 5000A S/ 207 bo. 7 hr.

2000 A P/ 90 bo 6 hr. Comp. 3000 bopd

J. E. TYRA