

Graham 10

KANSAS 21W

Sec. 2 Twp. R.

Well No. #3 Noah Farm

Phillips Company

Jones, Shelborne & Farmer Contractor

Cooper Pool


990' Ft. from N. Line

Ft. from S. Line

Ft. from E. Line

990' Ft. from W. Line

SE NW NW

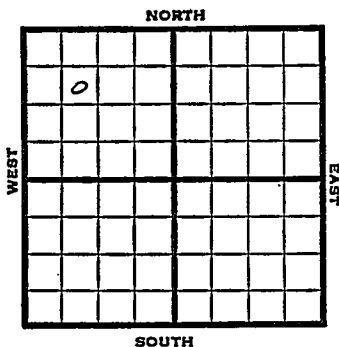

1951 Elev. 2255' REPORT

1/31 Spud 1-25-51
Anhy 1720
8" @ 1771
Drlg. 2260'

3/28 Spud 1-25-51
Oil well TD 3838'
Anhy 1720', 8" @ 1771', Howard 3247'
Top. 3275', Heeb. 3456',
Toronto 3478', Lans. 3498',
Arb. 3802-05', 5" @ 3803'
TD 3828' B/ 1 1/2 boph 500 A
S/ 1/2 boph DD 3834', FU 400' oil,
S/ 1/4 boph, DD 3838', S/ 3 boph
1500 A
Comp. 243 bopd

COMPLETED

County Graham State KansasSec. 2 (Blk. Twp.) 10 (Sur. Rge.) 21W Map No.Operator PhillipsWell No. 3 Farm NoahElev. 2255 Location SE NW NW

0					

990 Ft. From N Line NW990 Ft. From W Line Quarter1st. Report JAN 31 1951

Completion _____

Remarks _____

Jones, Shelborne & FarmerSpudding Date 1-25-51Drlg. Data Cooper PoolAnhy 1720 8" @ 1771 drlg. 2260

