


Section 2 Township 10 Range 21 W

Well No. # 5 Noah

Company Phillips Pet.

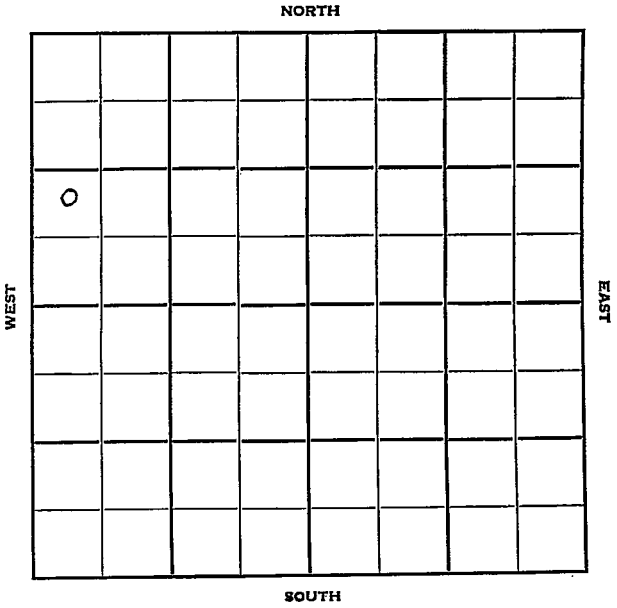

Sec. 2 Twp. 10 R. 21 W

Well No. # 5 Noah Farm

Phillips Pet. Company

Contractor

Cooper Pool


Ft. from N. Line

990 Ft. from S. Line

Ft. from E. Line

330 Ft. from W. Line

NW SW NW

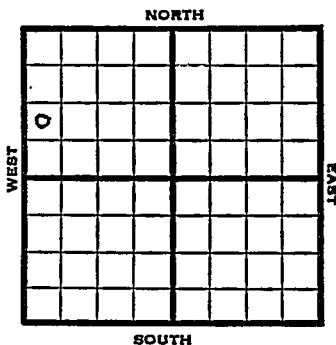

1951

Elev. 2289'

REPORT

3/28

R U R

5/9

Spud 3-28-51

Oil well TD 3840'

Anhy 1767', 8" @ 1809' Howard 3273'

Top. 3301', Heeb 3483', Tor. 3503',

Lans. 3525', B KC 3748', Arb. 3822',

5" @ 3823' TD 3839' S/109 BO 2 hr.

DD 3840' S/118 BO 2 hr.

Comp. 3000 BOPD

COMPLETED

County Graham State Kansas

Sec. 2 (Blk. 10 (Sur. Rge.) 21W Map No.

Operator Phillips Pet.

Well No. 5 Farm Noah

Elev. 2289 Location NW SW NW

0							

COMPLETE

990 Ft. From S Line NW

330 Ft. From W Line Quarter

1st. Report

Completion MAY 9 1951

Remarks Cooper Pool

Spudding Date 3-28-51

Drlg. Data Oil well TD 3840

Anhy 1767 8" @ 1809 Howard 3273

Top. 3301 Heeb. 3483 Tor. 3503

Lans. 3525 B KC 3748 Arb. 3822

5" @ 3823 TD 3839 S/ 109 bo 2 hr.

DD 3840 S/ 118 bo 2 hr.

Comp. 3000 bopd