


Section 2 Township 10 Range 21W

Well No. #2 Sutor

Company Jones-Shelburne & Farmer

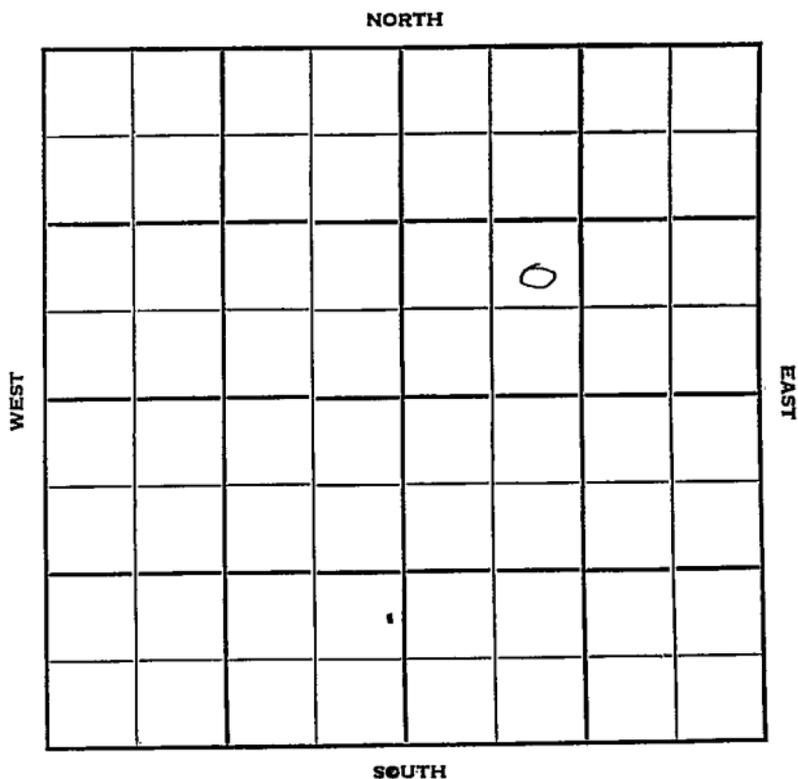

Graham

~~KANSAS~~

Sec. 2

Twp.

10

R.

21W

Well No. #2 Sutor

Farm

Jones-Shleburne & Farmer

Company

Contractor


\_\_\_\_\_ Ft. from N. Line

990' \_\_\_\_\_ Ft. from S. Line

\_\_\_\_\_ Ft. from E. Line

990' \_\_\_\_\_ Ft. from W. Line

NE SW NE

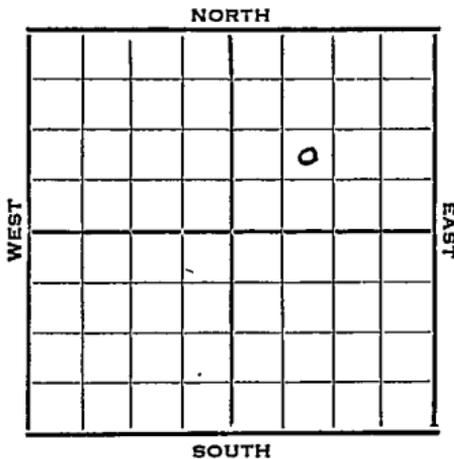

1951

Elev. 2290'

REPORT

12/19

Location

1952

2/6

Spud 1-5-52

Oil Well TD 3855

8" @ 150

Anhy 1750

Heeb. 3506

Tor. 3531

Lans. 3545

B KC 3789

Arb. 3852

5" @ 3853

TD 3855 500 A

S/ 12 BOPH

8 hr. Comp. 201 BOPD

**COMPLETED**



County Graham State Kansas

Sec. 2 (Blk. 10) (Sur. 21W) (Twp.) (Rge.) Map No.

Operator Jones, Shelborne & Farmer

Well No. 2 Farm Sutor

Elev. 2290 Location NE SW NE


990 Ft. From S Line NE

990 Ft. From W Line Quarter

1st. Report

Completion FEB 6 1952

Remarks

**COMPLETE**

Spudding Date 1-5-52

Drig. Data Oil well TD 3855

8" @ 150 Anhy 1750 Heeb. 3506

Tor. 3531 Lans. 3545 B KC 3789

Arb. 3852 5" @ 3853 TD 3855 500 A

S/ 12 boph 8 hr. Comp. 201 bopd

J. G. McGEHEE