


Section 2 Township 10 Range 21W

Well No. #1 White

Company Skelly Oil

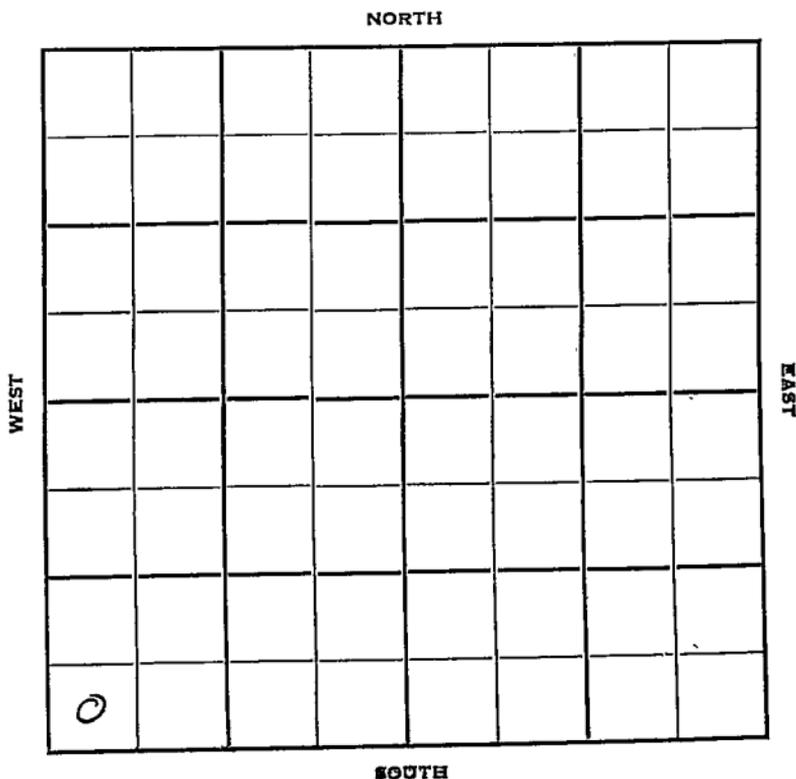

Sec. 2 Twp. 10 R. 21-W

Well No. #1 White Farm

Skelly Oil Company

Wentworth - Contr. Contractor

Bass


_____ Ft. from N. Line

330 Ft. from S. Line

_____ Ft. from E. Line

330 Ft. from W. Line

SW SW SW

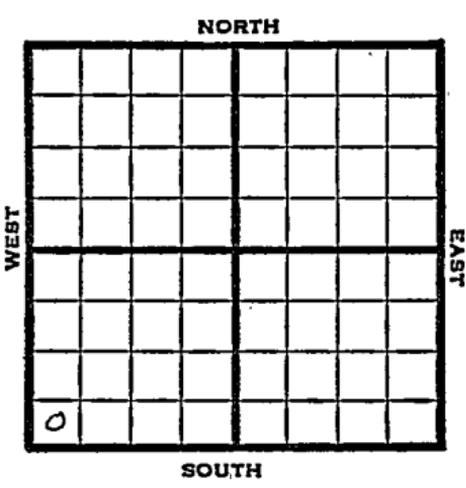

1950

Elev. 2271' REPORT

9/13

Location

11/1

Spud 9-19-50
 Oil Well TD 3845'
 8" @ 298' Top 3305'
 Heeb. 3484' Lans. 3524'
 Cong. 3795' Simp. 3811'
 Arb. 3814-45' 5" @ 3841'
 FU 1800' oil 1 hr 2560' oil 5 hr.
 P/131 BO 8 hr 250A P/72 BO 4 hr.
 Draw down pot. 2453 BOPD

COMPLETED


County Graham State Kansas

Sec. 2 (Blk. 10 (Sur. 21W Map No. (Twp.) (Rge.))

Operator Skelly Oil

Well No. 1 Farm White

Elev 2274 Location SW SWSW

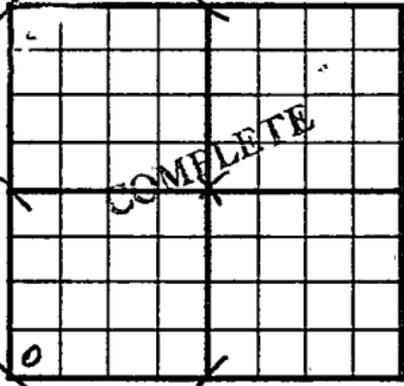

330 Ft. From S Line SW

330 Ft. From W Line Quarter

Ist. Report

Completion NOV 1 1955

Remarks NW Bass Pool

Wentworth - Contr.

Spudding Date 9-19-50

Drlg. Data Oil well TD 3845

8" @ 298 Top. 3305 Heeb. 3484

Lans. 3524 Cong. 3795 Simp. 3811

Arb. 3814-45 5" @ 3841 FU 1800' oil

1 hr. 2560' oil 5 hr. P/ 131 bo 8 hr.

250 A P/ 72 bo 4 hr.

Draw down pot. 2453 bopd

J. E. TYRA