

Sec. 2 Twp. 10 R. 21W

Well No. #4 White Farm

Skelly Oil Company

Wentworth - Contr. Contractor

Cooper Pool

Ft. from N. Line


990'

Ft. from S. Line

Ft. from E. Line

990'

Ft. from W. Line

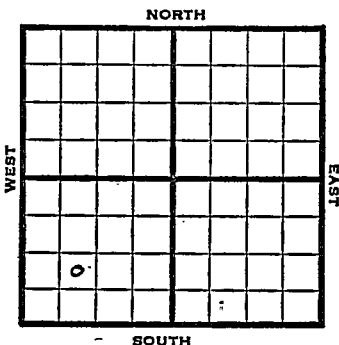

NE SW SW

1950

Elev 2266'

REPORT

11/15

Location

12/20

Spud 11-15-50

8" @ 297

Top 3296

Heeb 3475

Lans 3513

Cong 3782

Arb 3822-27

5" @ 3823

TD 3834

FU 300' oil 8 hr

S/34 bo 2 1/2 hr

500 A

P/122 bo 1 1/4 hr

DD 3837 100 A

Comp 332 bopd

Completed TD 3837'

COMPLETED

