


Section 2 Township 10 Range 21W

Well No. #5 White

Company Skelly Oil

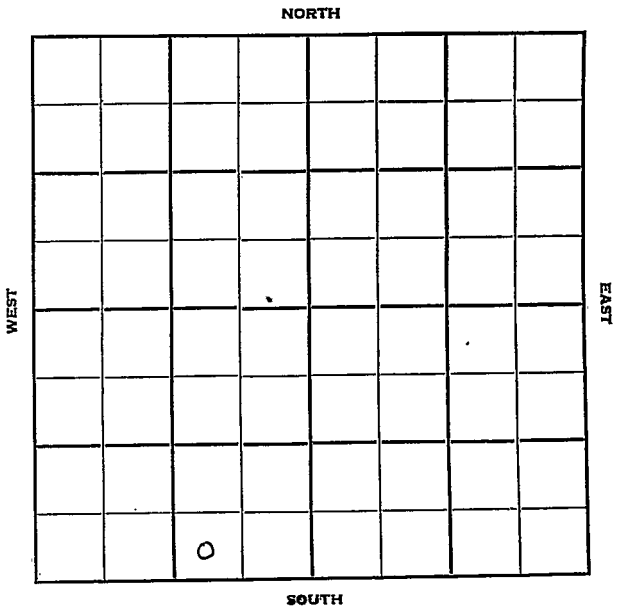

Graham

KANSAS

Sec. 2 Twp. 10 R. 21W 1/1

Well No. #5 White Farm

Skelly Oil Company

Cooper Pool Contractor


Ft. from N. Line

330' Ft. from S. Line

990' Ft. from E. Line

Ft. from W. Line

SW SE SW

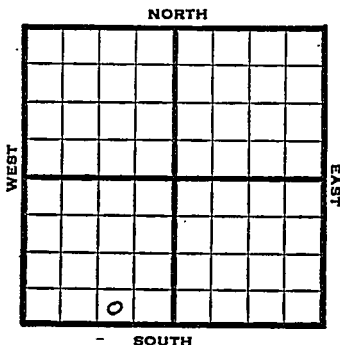

1950

Elev. 2232' REPORT

12/6

Spud 12-1-50
8" @ 285'

12/27

Spud 12-1-50
Oil Well TD 3799
8" @285 Heeb. 3444
Lans. 3485 Cong. 3762
Simp. 3773 Arb. 3791-99 TD
5" @ 3792 EU 1800' oil
1 hr P. 153 bo 8 hr
500 A P/199 bo 10 hr
1500 A P/239 bo 12 hr
Comp. EPI 2943 bopd

COMPLETED

