


Section 2 Township 10 Range 21W

Well No. #6 White

Company Skelly Oil

NORTH

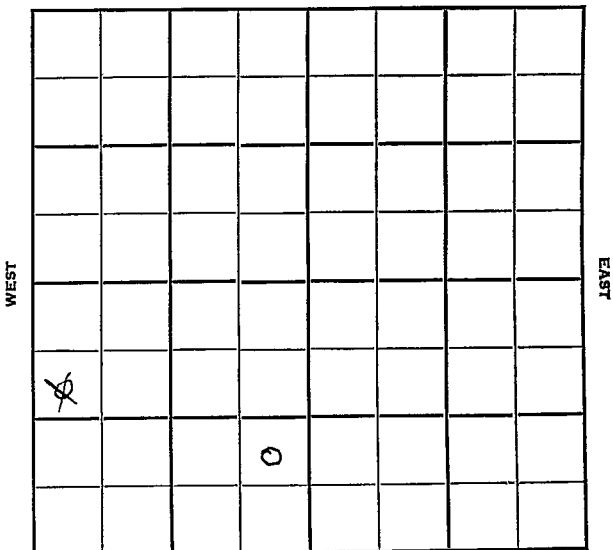

SOUTH

Sec. 2 Twp. 10 R. 21W

Well No. #6 White Farm

Skelly Oil Company

Contractor

Cooper Pool


990' Ft. from N. Line

990 Ft. from S. Line

330 Ft. from E. Line

330' Ft. from W. Line

NE SE
SW NW SW

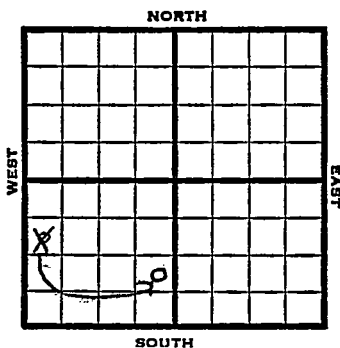

1950

Elev. ²²⁵⁷/~~2286~~ REPORT

12/13
¹⁹⁵¹
1/31

Drig.
Spud 12/27/50
Oil well TD 3809
8" @295
Top. 3280 Heeb. 3458 Lans. 3498
Cong. 3773 Simp. 3794 Arb. 3797-3800
5" @3798 TD 3809
FU 2800' oil 6 hr. S/ 70 bo 3 hr.
1000 A P. 180 bo 9 hr.
Comp. 3000 bopd

COMPLETED

Map No. _____ Sec. 2 Twp. 10 R. 21W

Well No. 6 White

Skelly Oil Company

CORRECTION

_____ Contractor

EI. 2257

NE SE SW

SECTION PLAT

_____ Ft. from N. Line

990 Ft. from S. Line

330 Ft. from E. Line

_____ Ft. from W. Line

Graham County

Location _____

Rig up _____

Drilling and Remarks:

Location at
SW NW SW not
drilled. Elev.
corrected from
2286 to 2257

RECORD

Cased _____ in., _____ ft.

Sand _____

Gas _____

Oil _____

Total Depth _____

PRODUCTION

1st 24 hrs. Nat. _____

1st 24 hrs. after shot _____

Gas _____ Cu. Ft.

Dry Hole _____

Abandoned _____

Date

JAN 3 1951 19

J. E. TYRA

Scout

