



Graham

KANSAS ✓

Sec. 2 Twp. 10 R. 21W

Well No. #7 White Farm

Skelly Oil Company

Contractor

Cooper Pool


990' Ft. from N. Line

\_\_\_\_\_ Ft. from S. Line

\_\_\_\_\_ Ft. from E. Line

330' Ft. from W. Line

SW NW SW

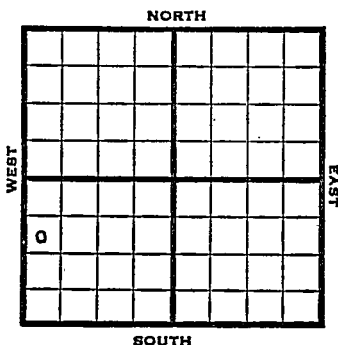

1951 Elev. 2286' REPORT

1/24 Spud 1-17-51  
8" @ 302'  
Drlg. 1770'

2/14 Spud 1-17-51  
D&A TD 3903  
8" @ 302' Heeb. 3507'  
Lans. 3548' Cong. 3807  
Arb. 3873'  
DST 3842-80 opn 1 hr Rec. 62' mud  
TD 3903' D&A

**ABANDONED**



County Graham State Kansas

Sec. 2 (Blk. 10) (Sur. Rge.) 21W Map No.

Operator Skelly Oil

Well No. 7 Farm White

Elev. 2286 Location SW NW SW

ABANDONED									

990 Ft. From N Line SW

330 Ft. From W Line Quarter

1st. Report

Completion FEB 14 1951

Remarks Cooper Pool

Spudding Date 1-17-51

Drlg. Data D & A TD 3903

8" @ 302 Heeb. 3507 Lans. 3548

Cong. 3807 Arb. 3873 DST 3842-80

open 1 hr. Rec. 62' mud TD 3903

D & A

J. E. TYRA