

Section 2 Township 10 Range 21WWell No. #8 WhiteCompany Skelly Oil

NORTH

	0						

WEST

EAST

SOUTH

Graham

KANSAS

Sec. 2 Twp. 10 R. 21W ✓

Well No. #8 White Farm

Skelly Oil Company

Cooper Pool Contractor


330' Ft. from N. Line

Ft. from S. Line

Ft. from E. Line

990' Ft. from W. Line

NE NW SW

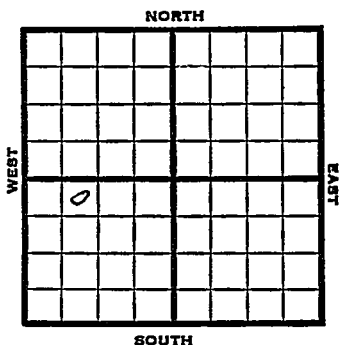

1951

Elev. 2270'

REPORT

2/7

Location

3/28

Spud 2-9-51

Oil well TD 3831'

8-5/8" @ 300

Heeb. 3477', Lans. 3522',

Stain 3741-43', Cong. 3780',

Simp. 3815', Arb. 3819', Stain 3818-

23', TD 3823', 5" @ 3820'

DD 3826', FU 1400' oil, DD 3831'

FU 2800' oil 10 hr. 500 A

S/ 152 bo 7 hr. P/ 158 bo 10 hr.

Ind. cap. 5843 bopd

COMPLETED

J. E. TYRA

J. E. TYRA