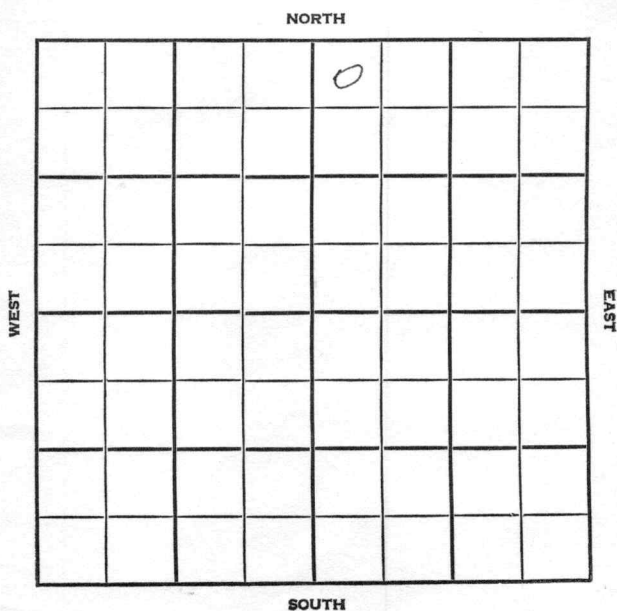


Section 2 Township 10 Range 22WWell No. #1 BrassfieldCompany Fortier & Brown & K & E Drlg

HOT FILE

Graham

KANSAS

SEC.

TWP.

R.

2

10 S

22 W

WELL NO.

1 Brassfield

FARM

COMPANY

Fortier & Brown & K & E Drlg.
~~Joe Nathan~~

CONTRACTOR

K & E Drlg.

____ FT. FROM N. LINE

____ FT. FROM S. LINE


____ FT. FROM E. LINE

____ FT. FROM W. LINE

NW NW NE

NE NE NW

SDX-Offset

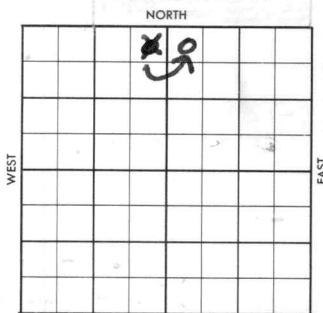

SOUTH

SDX FO (Lse S-11675 renewed as S-27219)

1956

ELEVATION

2329'

REPORT

(WH6-F09)

5/31

Base Kansas City Appx 3800'
Arbuckle Lime Test appx 4000'

To commence by June 1, 1956

To complete by July 1, 1956

(See FO Agreement 5/31/56)

6/12

FO Agreement of 6-12-56 replaces
FO agreement of 5/31/56 changing
test depth to Base of KC appx 3800'
and location to NW NW NE.

To commence by June 1, 1956

To complete by July 1, 1956

(See FO agreement 6/12/56)

?? Time Extension given??

6/27

Comm. 6-25-56

8" @ 224 w/150 WOC. (FR Ticket)

7/12

DST 3679-3721, op 1 hr, 1500' GIP,
rec 1250' oil & muddy oil, 250' O & W
1255#DST 3723-37, op 1 hr rec 1125' GIP,
rec 425' mud & GCO, 1110#DST 3739-55, op 1/2 hr, rec 25' OCM,
1065#. Arb. 3922'DST 3925-34, op 1/2 hr, rec 1840' wtr.
1060#

TD 3934' 5 1/2" @ 3814/125 WOCT

7/19

No report.

OVER

1956

7/26

CO 20/3769-74 500 A
B/30 GFPH 6 hrs. 50% PB 3761
14/3750-53 500 A S/35 GFPH 6 hrs
50% wtr. ~~PE~~ 16/3730-33 500 A
S/45 BO 2 hrs. PB 12/3688-90
12/3691-93, 16/3697-3700. 500 A
S/35 BOPH 2 hrs. CO 3740'
S/55 BOPH

8/2

No report.

8/9

"

8-16

"

8-23

P/ 248.48 BO , no wtr, 24 hrs.
Waiting on potential

8-30

No Report

9/5

Comm. 6-25-56
8" @ 224 w/150 WOC
Anhy 1810', Hb. 3515', Tr. 3539',
Lsg. 3553'
DST 3546-65, open 1 hr, rec 720' SW
FP 0-380#. BHP 1080#
DST 3580-3600, 1 hr, rec 120' MW
(specks of oil) FP 30-70#. BHP 1200#
DST 3618-43, op 30", rec 660' wtr.
FP 80-360#. BHP 1300#.
DST 3679-3721, op 1 hr, rec 1500'
GIP, rec 1250' oil & muddy oil + 250'
oil & wtr. FP 310-640#. BHP 1255#
DST 3723-37, op 1 hr, 1125' GIP, rec
425' Mud & GCO. FP 50-180#. BHP 1110#
DST 3739-55, op 30", rec 25' OCM.
BHP 1065# Arb. 3922'
DST 3925-34, op 30", rec 1840' W,
FP 200-800#. BHP 1060#. RTD 3934
5 $\frac{1}{2}$ " @ 381 w/125 WOCT. CO ?
20/3769-74, no test. B/30 GFPH 6 hrs.
50% wtr. PB 3761 14/3750-53
No test nat. S/35 GFPH 6 hrs. 50% wtr
PB ? 16/3730-33 S/45 BO 2 hrs,
no wtr. PB ? 12/3688-90 12/3691-93
16/3697-3700 S/35 BOPH no wtr. 2 hrs.
CO 3740? To test both zones.
S/55 BOPH no wtr. 1200' oil?
~~MM~~ P/248.48 BO no wtr. 24 hrs.
WO Potential
Ph.P/368 BOPD no water.
Lansing Perfs 3691-3730
RTD 3934' COTD 3740'

COMPLETED

9/18 (Advised Contract Section-Gomp.-Oil Well)

County Graham Elev. _____
 Sec. 2 Twp. 10 Rge. 22W
 Company Fortier & Brown & K & E Drlg.
 Farm Name Brassfield No. 1

TOPS	DEPTH	LOG	DATUM	Loc. in Sec.
Anh.				NW NW NE
Tr.				
H.				
Tr.				
Dg.				
Bl.				
L.				Geol. _____
K.C.				Contr. _____
B.K.C.				
Ce.				K & E
C.				
M.				Pool
M.				
K.				
Mz.				
Ma.				
V.				
S.				
S.				
A.				
R.				
Pe.				
G.				
T.D.				

0

offset

FIRST REPORT

JUN 27 '58

Date Comm. 6-25-56
8" @ 224/150 WOC

JUL 1 1958

R. G.

County Graham Elev. 2329
 Sec. 2 Twp. 10 Rge. 22W
 Company Fortner & Brown & K & E Drilg.
 Name Brassfield No. 1

OPS	DEPTH	LOG	DATUM	Loc. in Sec.
	1810			NW NW NE
Tr.	3515			
H.	3539			
Tr.				
Dg.				
Bl.				
L.	3553			Geol.
K.C.				
B.K.C.				Contr.
Ce.				K & E
C.				
M.				Pool
M.				
K.				
Mz.				
Mq.				
V.				
S.				
S.				
A.	3922			
R.				
Pe.				
G.				
TD.	3934			COMPLETE

Date Comm. 6-25-56

8" @ 224/150 WOC JUL 3 '56 Anhy 1810

H6 3515 Tr 3539 L59 3553 DST
 3546-65 op 1 hr rec 720' SW
 FP 0-380 BHP 1080 DST 3580-3600
 1 hr rec 120' MW (specks of oil)
 FP 30-70 BHP 1200 DST 3618-43
 op 30" rec 660' WTA FP 80-360
 BHP 1300 JUL 11 '56 DST 3679
 -372.1 op 1 hr 1500' Bhp rec 1250'

SEP 5 '56

2-10-22

NW NW NE

Oil & Muddy oil + 250' oil & wtr

FP 310-640 BHP 1255 DST 3723

- 37 op 1 hr 1125' GIP rec 425

Md & CCo FP 50-180 BHP 1110

DST 3739-55 op 30" rec 25' OCM

BHP 1065 Arb 3922 DST 3925

- 34 op 30" rec 1840' W FP 200-800

BHP 1060 RTD 3934 5 1/2 @

3814/125 WOCT JUL 18 '56 JUL 25 '56

CO ? 20/3769-74 no +st + 1/2

PB 30 GFPH 6 hrs 50% wtr

PB 3761 14/3750-53 notst not.

1/2 & 35 GFPH 6 hrs 50% w

PB : 16/3730-33 1/2 &

45 BO 2 hrs no/w PB 12/

3688-90 12/3691-93 16/3697

- 3700 1/2 & 35 Boph no/w

2 hrs CO 3740? To +st

both zones. & 55 Boph no/w

1290' O.B. AUG 1 '56

AUG 8 '56

AUG 15 '56

AUG 22 '56

P. 248.48 BO

no/wtr 24 hrs wo Pot. AUG 29 '56 SEP 5 '56

X wo Pot. Ph P. 368 Bopd

no/wtr.

Lsg PFs. 3691-3730

RTD 3934 COTP 3740

2-10-22

NW NW NE