
Graham KANSAS

SECTION 2 TOWNSHIP 10S RANGE 22W

WELL NO. #2 Brassfield

COMPANY Kerfoot ~~Frontier~~, Brown & K&E

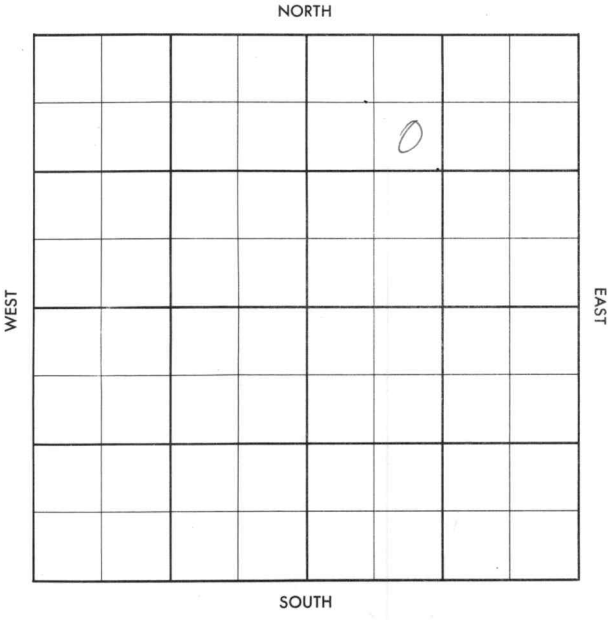

FORM 504-3 SUNRAY

FORM 513 SUNRAY

County Graham Elev.

Sec. 2 Twp. 10S Rge. 22W

Company Frontier, Brown & K & E

Farm Name Brassfield No. 2

TOPS	DEPTH	LOG	DATUM
Anh.			
T.P.			
H.			
Tr.			
Dg.			
B.L.			
L.			
K.C.			
B.K.C.			
Ce.			
C.			
M.			
M.			
K.			
Mz.			
Mc.			
V.			
S.			
S.			
A			
R.			
P€.			
G.			
T.D.			

Loc. in Sec. SE NW NE

Geol.

Contr. K & E #2

Pool Brassfield

FIRST REPORT
OCT 3 '56

Date Comm.

Loc.

Co. Lse. No. Sec. T. R.

CORRECTION

FORM 513 SUNRAY

County Graham Elev. 2323

Sec. 2 Twp. 10S Rge. 22W

Company ~~Frontier~~ Fortier, Brown & K & E

Farm Name Brassfield No. 2

TOPS	DEPTH	LOG	DATUM
Anh.	1805		
Tp.			
H.	3515		
Tr.	3537		
Dg.			
Bl.			
L.	3551		
K.C.			
B.K.C.	3780		
Ce.			
C.			
M.			
M.			
K.			
Mz.			
Mc.			
V.			
S.			
S.			
A			
R.			
P€.			
G.			
T.D.	3810		

Loc. in Sec. SE NW NE

Geol.

Contr. K & E #2

Pool Brassfield

DEC 5 '56

COMPLETE

Date Comm.

Loc. OCT 10 '56 10-3-56 8 7/8 230

1150 DST 3676-3706 1 hr 350'

Gip rec 50' HO&GCM + 150'

Frothy oil + 100' clean oil FP

60-140 BHP 1150/20" ✓ 3718

OCT 17 '56 DST 3713-35 1 hr rec

1250' gas + 15' SO&GCM + 30'

HO&GCM + 80' VHO&GCM + 110'

Frthy oil 140' Free oil 45 - 22

Co. Lse. No. Sec. T. R.

FORM 513-1 SUNRAY

BHP 850/20 5½ @ 3780/150
OCT 24 '56 24/3688-94 & ¼ TO
½ Bo ph /½ & 12 Bo ph
2 hrs no/w 20/3725-30
OCT 31 '56 ~~co~~ T & R POP NOV 7 '56
NOV 13 '56 NOV 21 '56 NOV 28 '56 W.O. Pot.
P. 100 Bopd DEC 5 '56 X Ph P.
302 Bopd no wtr grav 36° corrected
Lsg PF 3688-3730 (overall)
RTD 3810 PBTD 3750?

2-10-22 [illegible]