

Graham


KANSAS

SECTION 2 TOWNSHIP 10 RANGE 22W

WELL NO. #3 Brassfield

COMPANY K & E Drlg. & Brown & Fortier

NORTH

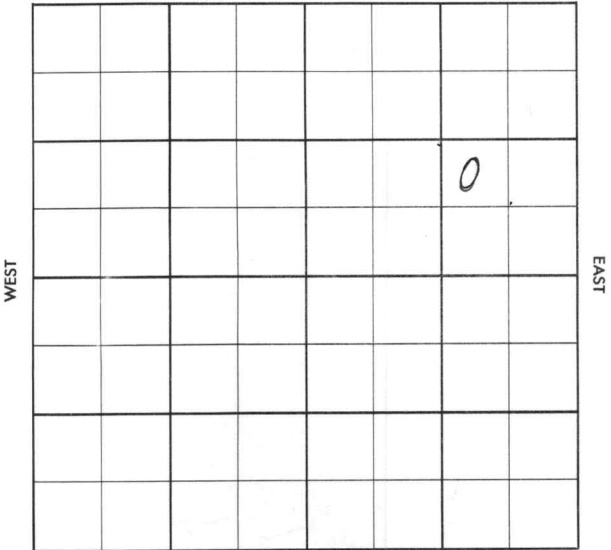

WEST

EAST

SOUTH

County Graham Elev. _____
 Sec. 2 Twp. 10 Rge. 22W
 Company K & E Drlg. & Brown & Fortier
 Farm Name Brass field No. 3

TOPS	DEPTH	LOG	DATUM	Loc. in Sec.
Anh.				NW SE NE
Tr.				
H.				
Tr.				
Dg.				
BL.				
L.				Geol. _____
K.C.				Contr. _____
B.K.C.				K & E Tools
Ce.				
C.				Pool
M.				Brassfield
M.				
K.				
Mz.				
Mq.				
V.				
S.				
S.				
A.				
R.				
PE.				
G.				
T.D.				

Date Comm. 12-23-56
8" @ 242 w/115, WOC

FIRST REPORT
 DEC 28 56

5

County Graham Elev. 2324 DF
 Sec. 2 Twp. 10 Rge. 22W
 Company K & E Drlg. & Brown & Fortier
 Farm Name Brass field No. 3

TOPS	DEPTH	LOG	DATUM	Loc. in Sec.
Anh.				NW SE NE
Tr.				
H.	3523			
Tr.	3545			
Dg.				
Bl.				
L.	3560			Geol.
K.C.				Contr.
B.K.C.				K & E Tools
Ce.				
C.				Pool
M.				Brassfield
M.				
K.				
Mz.				
Mq.				
V.				
S.				
S.				
A.				
R.				
PE.				
G.				
TD	3810			

FEB	3	57
	X	O
COMPLETE		

Date Comm. 12-23-56

8" @ 242 W/115, WOC JAN 2 '57 H6 3523

Tr 3545 Lsg 3560 DST 3685-3725

op 1 hr 240' gas rec 70' HO 86CM
+ 120' Fr 999 oil BHP 860/20"

DST 3725-50 op 1 hr 6/40"

rec 1736' 9354 oil FP 150-600

BHP 1125/20" RTD 3810 Ran

Log prep to run pipe JAN 9 '57 X

5 1/2 @ 3809/100 MICT CO PF

36/ 3739-48 FU 1040' oil
 no/w 1hr \$ 30 Bopd no/w
 2 hrs Pop (nat.)

JAN 10 '57

JAN 23 '57 JAN 30 '57

FEB 6 '57

FEB 13 '57

Ph P 563 Bopd no/w
 grav 38°