


C.W.W.O.

Section 2 Township 10 Range 22 W

Well No. #1 Callison Est. "A"

Company K & E Drlg.

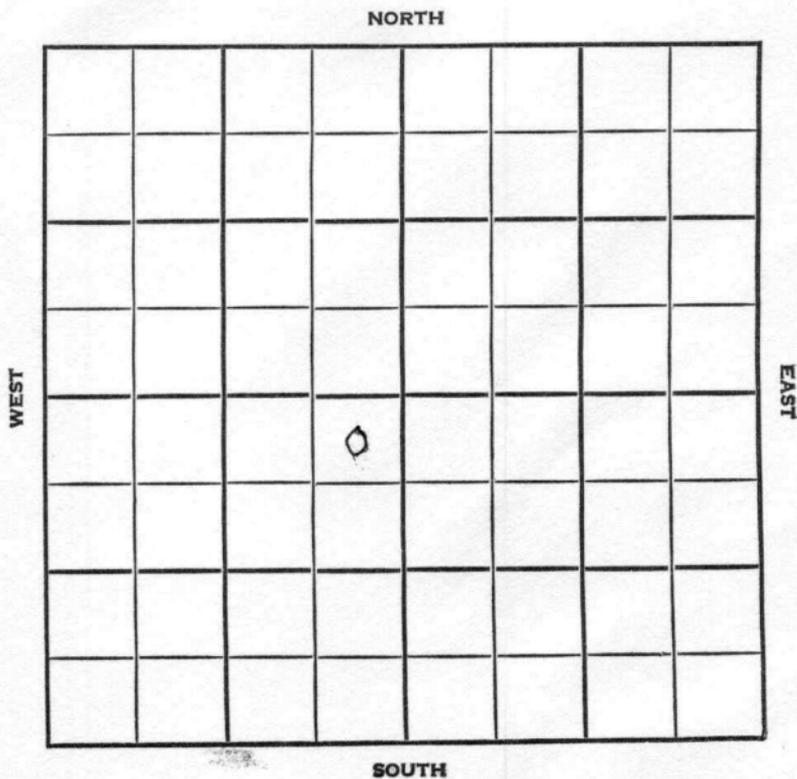

HOT FILE Graham

KANSAS

SEC.	TWP.	R.
2	10	22 W

WELL NO.

1 Callison Est.

FARM

COMPANY

K & E Drlg.

CONTRACTOR


Co. tools
Wildcat

_____ Ft. from N. Line

_____ Ft. from S. Line

_____ Ft. from E. Line

_____ Ft. from W. Line

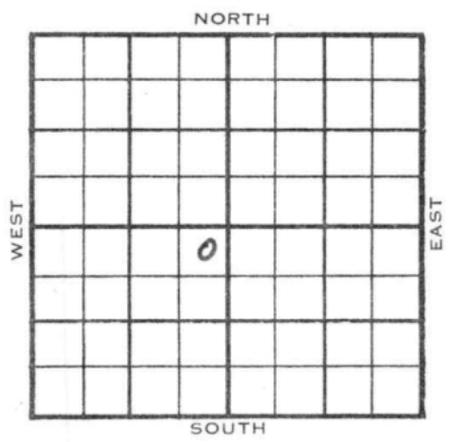

NE NE SW

SDX Lse - 1/2 Mile

	ELEVATION	REPORT
1955	2336'	

9/7	Location
9-8	"
9-15	Spud 9-6-55 8 5/8" @ 210/135 Drlg. 3380
9-21	DST 3597-3617 op 1 hr. rec 230' wtry mud, BHP 1215#; DST 3642-55 op 1 hr. rec. 240' so&gcwm 105' vso&gcw 600' wtr., BHP 1240#; DST 3661-76 op 30" rec. 730' sw, BHP 1160# 15"; DST 3729-36 op 30" rec 10' mud, specks oil, BHP 0# 15" DST 3756-62 op 30" rec. 15' mud BHP 0# 15"; D & A Tops: Anh. 1815 H. 3531 Tr. 3552 L. 3567 B.K.C. 3793 Marm Ch 3857 Chert 3897 A 3950 T.D. 3967'

ABANDONED

County **Graham** Elev. **2336**
 Sec. **2** Twp. **10S** Rge. **22W**
 Company **K & E Drlg.**
 FarmName **Callison** No. **1**

TOPS	DEPTH	LOG	DATUM	Loc. in Sec.
Anh.	1815			NE NE SW
TP.				
H.	3531		1195	
Tr.	3552		1216	
Dg.				
Bl.				
L.	3567		1231	Geol.
K.C.				Contr.
B.K.C.	3793		1457	
Marm Ch	3857		1523	Co. tools
C. Chert	3897		1561	
M.				Pool
M.				Wildcat
K.				
Mz.				
Mq.				
V.				
S.				
A.	3950		1614	
R.				
PE.				ABANDONED
G.				
TD.	3967			

Date Comm. **9-6-55** SEP 21 1955

8-5/8" 210 w/135; DST 3597-3617 op 1 hr.
rec. 230' wty mud, BHP 1215#; DST 3642-55
op 1 hr. rec. 240' so and gcwm, 105' vso
& gcw 600' wtr., BHP 1240#; DST 3661-76
op 30" rec. 730' sw, BHP 1160# 15"; DST
3729-36 op 30" rec. 10' mud, specks oil,
BHP 0# 15"; DST 3756-62 op 30" rec. 15' mud
BHP 0# 15"; D & A

Co.
Lse.
No.
Sec.
T.
R.

County ~~Graham~~ Elev. _____
 Sec. **2** Twp. **10** Rge. **22W**
 Company **K & E Drlg.**
 Farm Name **Callison Est.** No. **1**

TOPS	DEPTH	LOG	DATUM
Anh.			
Tp.			
H.			
Tr.			
Dg.			
Bl.			
L.			
K.C.			
B.K.C.			
Ce.			
C.			
M.			
M.			
K.			
Mz.			
Mq.			
V.			
S.			
S.			
A.			
R.			
PE.			
G.			
T.D.			

Loc. in Sec. **NE NE SW**
 Geol. _____
 Contr. _____
 Co. tools _____
 Pool **Wildcat**

$\frac{1}{2}$ mile	
FIRST REPORT	
SEP 7 '58	

Date Comm. _____
 Location _____

Co.
Lse.
No.
Sec.
T.
R.

O.W.W.O.

County Graham Elev. _____
 Sec. 2 Twp. 10S Rge. 22W
 Company K & E Drlg. etal
 FarmName Callison Est. No. 1

TOPS	DEPTH	LOG	DATUM
Anh.			
TP.			
H.	3537		
Tr.	3552		
Dg.			
Bl.			
L.	3567		
K.C.			
B.K.C.	3793		
Ce.			
C.			
M.			
M.			
K.			
Mz.			
Me.			
V.			
S.			
S.			
A.			
R.			
PE.			
G.			
TD.			

OWWO
 Loc. in Sec. _____
NE NE SW
 Geol. _____
 Contr. _____
E & E
 Pool _____

FIRST REPORT	
OCT	3 '55

Date Comm. Old info - OTD 3967; was Arb. test D & A

New info - MIRT; CO 3810; PB TD; DST 3685-3730 (straddle packer) 1 hr. rec. 158'
sli oil & gas cut mdu, 120' hvy oil & gas cut mud, BHP 1210# 20"; 4" 3810 w/400;

R.G.R

Co. Lse. No. Sec. T. R.

County Graham Elev. 2336 DF
 Sec. 2 Twp. 10S Rge. 22W
 Company K & E Drilg. etal
 Farm Name Callicon Est. "A" No. 1

TOPS	DEPTH	LOG	DATUM	Loc. in Sec.
Anh.				NE NE SW
Tp.				
H.	3531			
Tr.	3552			
Dg.				
Bl.				
L.	3567			Geol.
K.C.				Contr.
B.K.C.	3793			<u>N & E</u>
Ce.				Pool
C.				
M.				
M.				
K.				
Mz.				
Mo.				
V.				
S.				
S.				
A.				
R.				
PE.				
G.				
TD.				

OCT 10 1956
 ABANDONED

Date Comm. Old info - OTD 3967; was Arb. test D & A

Now info - MIRT; CO 3810; PE TD; DST 3685-3730 (straddle packer) 1 hr. rec. 158'

slt oil & gas out mud, 120' hvy oil & gas out mud, BHP 1210# 20"; 4" 3810 w/400;

OCT 10 '56 CO 16/3704-08 12/3712 -15' @ 1 Boph nat 12' @ 16 BOPh 50% wtr @ 97% wtr after 16 hrs D&A