


DX 78-1

Graham KANSAS

Section 2 Township 10 Range 23W

Well No. 1 Denning

Company Heathman-Seeligson

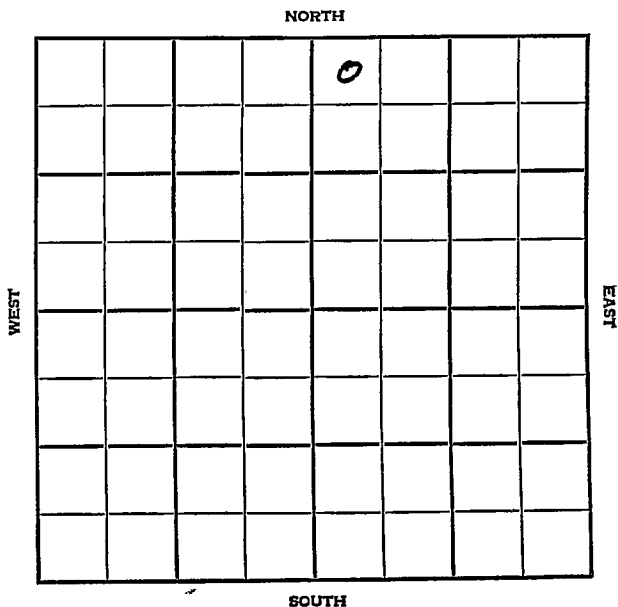

Graham KANSAS

SEC.	TWP.	R.
2	10	23W

WELL NO.

1 Denning FARM
COMPANY

Heathman-Seeligson
CONTRACTOR

Co. Tools


Law Pool

330 Ft. from N. Line

Ft. from S. Line

Ft. from E. Line

330 Ft. from W. Line

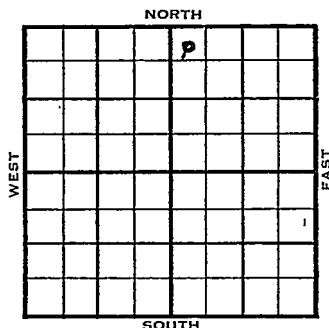

NW NW NE

1955

ELEVATION

2436'

REPORT

2/2

Spud 1-31-55
8" @ 160', WOC

2/16

Spud 1-31-55

D & A

TD 3937'

8" @ 160'

Anhy 2017' Heeb 3694' Lans 3731'

DST 3732'-58' opn 2 hr, rec 42' Mud, 135#

DST 3764'-98' opn 1 hr, rec 40' Mud, 350#

DST 3877'-3937' opn 2 hr, rec 60' Mud 120#

TD 3937'

D & A

ABANDONED

County Graham State Kansas
 Sec. 2 (Blk.) 10 (Sur.) 23W Map No.
 Operator Heathman-Seeligson
 Well No. 1 Farm Denning
 Elev. _____ Location NW NW NE

330 Ft. From N Line NE

330 Ft. From W Line Quarter

1st. Report FEB 2 1955

Completion _____

Remarks _____

Co. tools

Spudding Date 1-31-55

Drilg. Data _____


Law Pool

8" @ 160

WOC

FABEN GILSTRAP

County Graham State Kansas
 Sec. 2 (Blk. 10 (Sur. 23W Map No.
 Operator Heathman-Seeligson
 Well No. 1 Farm Denning
 Elev. 2436 Location NW NWNE

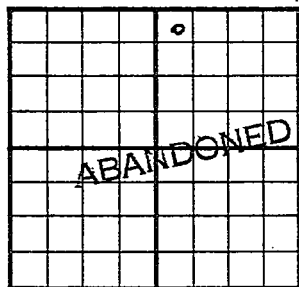

330 Ft. From N Line NE
330 Ft. From W Line Quarter
 1st. Report
 Completion FEB 1 6 1955
 Remarks Law Pool
Co. tools
 Spudding Date 1-31-55

Drlg. Data D & A TD 3937
8" @ 160 Anhy 2017 Heeb. 3694
Lans. 3731 DST 3732-58 open 2 hr.
Rec. 42' mud 135# DST 3764-98
open 1 hr. Rec. 40' mud 350#
DST 3877-3937 open 2 hr. Rec. 60' mud
120# TD 3937

D & A

FABEN GILSTRAP