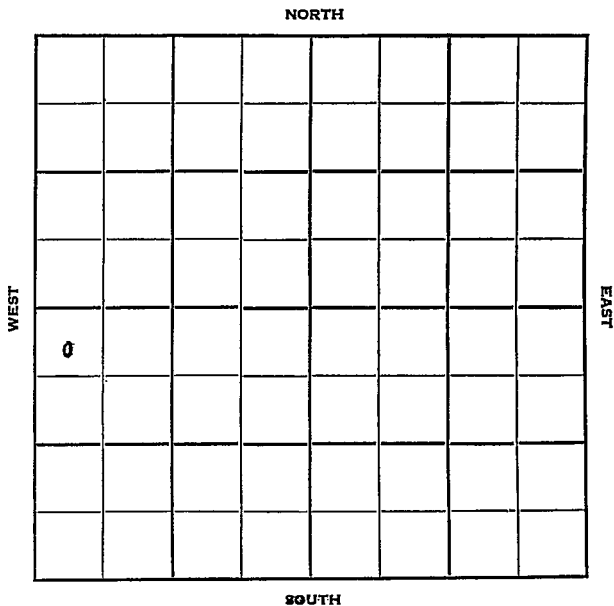


Section 2 Township 10 Range 23WWell No. #1 F. LawCompany H. Gore

Sec. 2 Twp. 10 R. 23W ✓

Well No. #1 F. Law Farm

H. Gore Company

Strain & Contr. Contractor

Law Pool


330' Ft. from N. Line

 Ft. from S. Line

 Ft. from E. Line

330' Ft. from W. Line

NW NW SW

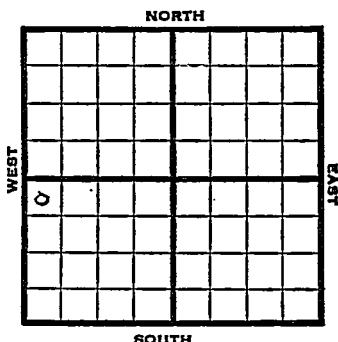

1951

Elev. 2437' REPORT

6/13

Location

9/12

Spud 6-14-51

Oil well TD 4268' 8" @ 178

Anhy 2005' Top 3477' Heeb 3689'

Lans. 3720'

DST 3787-3813' open 1 hr. rec 540' SOCW

DST 3903-28 open 1 hr. rec 12' mud

B KC 3955' Marm. 4046' Sand 4142-38

✓ DST 4124-38 open 1 hr. rec 240' oil.

Gong 4149' Arb. 4253'

TD 4268' 5" @ 4201 72/4126-42

56/4126-42 S/2 BOPH 5 hr.


P/41 BO 17 hr.

Comp. 77 BOPD

COMPLETED

3720
2437
1283
4253
2437
1816

at

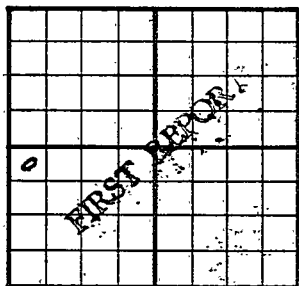County Graham State KansasSec. 2 (Blk. 10 (Sur. Rge. 23W Map No.Operator H. GoreWell No. 1 Farm F. LawElev. Location NW NW SW330 Ft. From N Line SW330 Ft. From W Line Quarter1st. Report JUN 13 1951

Completion

Remarks

Strain - Contractor

Spudding Date

Drlg. Data

Location Law Pool

J. E. TYRA

County Graham State Kansas

Sec. 2 (Blk. Twp.) 10 (Sur. Rge.) 23W Map No.

Operator Harry Gore

Well No. 7 Farm F. Law

Elev.	2437	Location	NW NW SW
-------	------	----------	----------

330 Ft. From N Line SW

330 Ft. From W Line Quarter

1st. Report _____

Completion SEP 12 1951

Remarks	Law Pool
---------	----------

Strain Drlg. - Contr.

Spudding Date 6-14-51

Drig. Data Oil well TD 4268

8" @ 178 Anhy 2005 Top. 3477

Heeb. 3689 Lans. 3720 DST 3787-3813

open 1 hr. Rec. 540' socw DST 3903-28

open 1 hr. Rec. 12' mud B KC 3955

Marm. 4046 Sand 4124-38 DST 4124-38

open 1 hr. Rec. 240' oil Cong. 4149

Arb. 4253 TD 4268 5" @ 4201 72/ 4126-

42 56/ 4126-42 S/ 2 boph 5 hr.

P/ 41 bo 17 hr. Comp. 77 bopd

J. E. TYRA