


Graham KANSAS

DX 78-1

Section 20 Township 10 Range 23W

Well No. 1 Guy R. Dorman

Company Stanolind

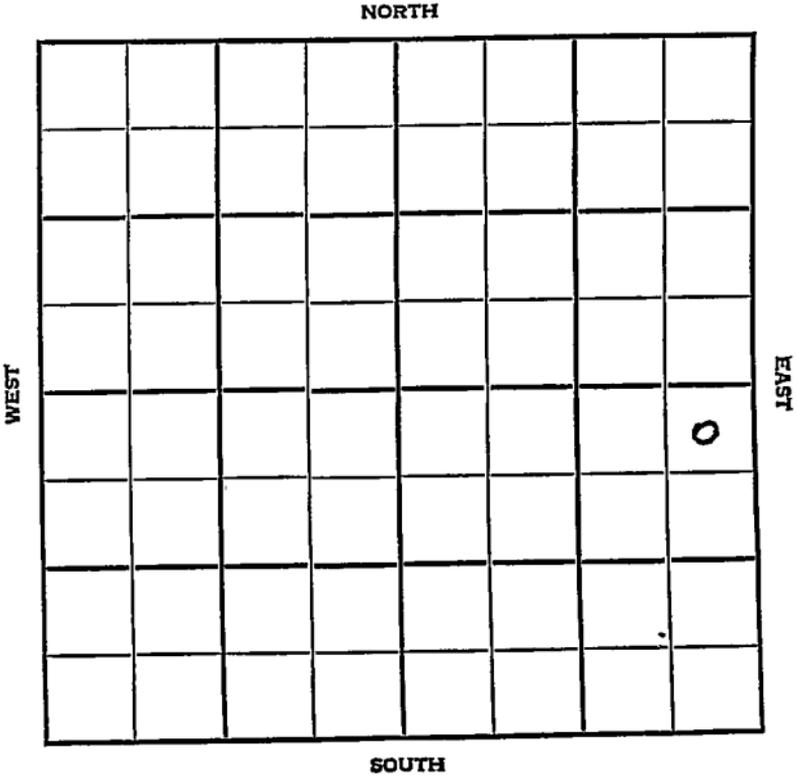

HOT FILE

Graham

KANSAS

SEC. 20 TWP. 10 R. 23 W

WELL NO. # 1 Guy R. Dorman FARM

COMPANY Stanolind

CONTRACTOR Transit Drlg.


Happy Pool

330 Ft. from N. Line

Ft. from S. Line

330 Ft. from E. Line

Ft. from W. Line

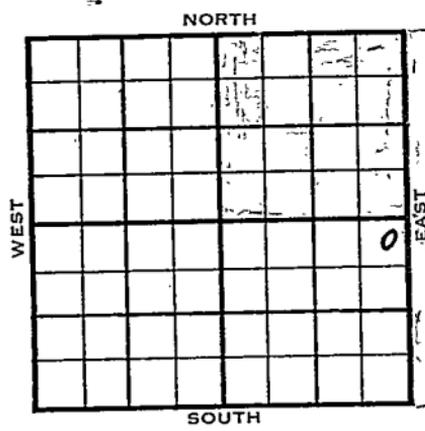

NE NE SE

	ELEVATION	REPORT
1954	2403	

6/15 Location

6/25 8" @ 203 Top 3412 Heeb 3630
 DST 3572-89 open 1 hr rec 155' mud,
 1200# Lans. 3662'
 DST 3684-98, open 1 hr, rec 1860'
 SO & GCSW, 930#
 DST 3704-12, open 1/2 hr rec 2250' SW
 4280#
 DST 3821-35, open 11 min, gas in 11
 min, rec 1450' oil, 1125#
 DST 3841-54, open 1 1/2 hr, rec 115' gas,
 40' G & OCM. Off
 DST 3862-70 open 1 hr rec 180' SO &
 GCSW, 1215#. RTD 3923' (Ltr-McGehee)

7/1 5" @ 3922' "

7/8 GO to 3905' 16/3882-86 1/4 GW 1 GO
 Sd-oil-frac. S/25 BOPH SP 3870
 16/3846-50 16/3829-33 3000 A
 S/33 BOPH 1/4 hr. S/16 BOPH (Ltr-McGehee)

7/22 Completed for a BHB test of 2267
 BOPD + 8% wtr. (Ltr-McGehee)

7/21 Spdg 6-14-54
 Oil well
 TD 3923

OVER


1954
7/21

Information brought forward

8" @ 203
Top 3412 Heeb 3630
DST 3572-89 open 1 hr. Rec. 155' mud
1200#
Lans. 3662
DST 3684-98 open 1 hr. Rec. 1860' so &
gcsw 930#
DST 3704-12 open $\frac{1}{2}$ hr. Rec. 2250' sw
1280#D
DST 3821-35 open 11 min. Rec. 1450'
oil 1125#
DST 3841-54 open $1\frac{1}{2}$ hr. Rec. 115' gas
40' g& ocm 0#
DST 3862-70 open 1 hr. Rec. 180' so &
gcsw 1215#
TD 3923
5" @ 3922 CO to 3905 16/ 3882-86
4 gw 1 go sd-oil-frac S/ 25' boph
SP 3870 16/ 3846-50 16/ 3829 -33
3000 A 33 Boph 4 hr. S/ 16 boph
Comp. 2267 bopd 8 % wtr.

COMPLETED

County Graham State Kansas
 Sec. 20 (Blk.) 10 (Sur.) 23W Map No.
 Operator Stanolind
 Well No. 1 Farm Guy R. Dorman
 Elev. 2403 Location NE NE SE

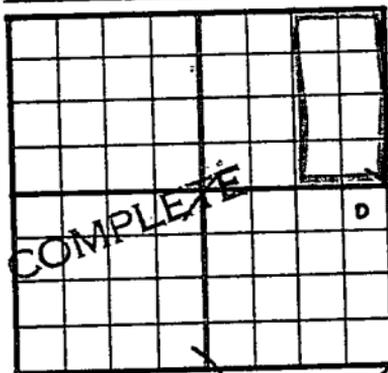

330 Ft. From N Line SE
330 Ft. From E Line Quarter
 1st. Report _____
 Completion JUL 21 1954
 Remarks Happy Pool
Transit Drlg. - Contr.
 Spudding Date 6-14-54

Drlg. Data Oil well TD 3923
8" @ 203 Top. 3412 Heeb. 3630
DST 3572-89 open 1 hr. Rec. 155' mud
1200# Lans. 3662 DST 3684-98 open 1 hr
Rec. 1860' so & gcsw 930# DST 3704-12
open 1/2 hr. Rec. 2250' sw 1280#
DST 3821-35 open 11 min. Rec. 1450' oil
1125# DST 3841-54 open 1 1/2 hr. Rec.
115' gas 40' g & ocm 0# DST 3862-70
open 1 hr. Rec. 180' so & gcsw 1215#
TD 3923 5" @ 3922 CO to 3905
16/ 3882-86 4 gw 1 go sd-oil-frac
S/ 25 boph SP 3870 16/ 3846-50
16/ 3829-33 3000 A 33 boph 4-hr.
S/ 16 boph Comp. 2267 bopd 8% wtr.

J. G. McGEHEE