


DX 78-1

Section 20 Township 10S Range 23W

Well No. 1 1/2 Guy R. Dorman

Company Stanolind Oil

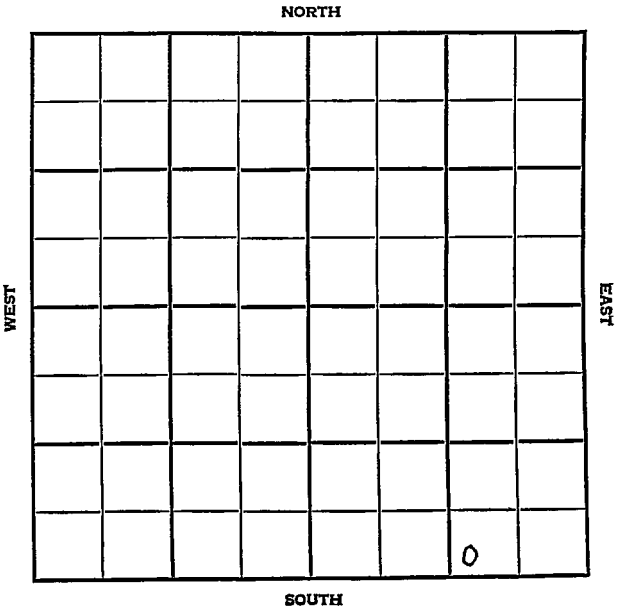

Graham

KANSAS

SEC.	TWP.	R.
20	10S	23W

WELL NO. **4 Guy R. Dorman** FARM

COMPANY **Stanolind Oil**

CONTRACTOR


Happy

_____ Ft. from N. Line

_____ Ft. from S. Line

_____ Ft. from E. Line

_____ Ft. from W. Line

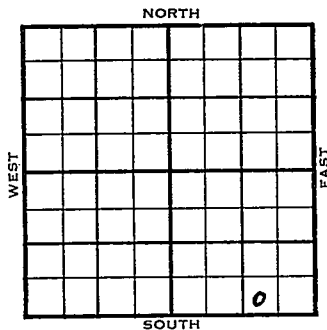

SW SE SE

1955	ELEVATION	REPORT
6/29	2409	<p>Comm 5-9-55 Anh 1967 H 3637 Tr 3656 L 3672 BKC 3914 TD 3940 8 5/8" @ 197 w/150 DST 3771-3809 op 1 hr Rec 2160' SGCSW BHP 1170# TSTD 2 BOPH no wtr 1 hr 16/3840-44 tstg 3 1/2 BOPH no wtr 2 hrs, POP BH Bomp 1492 no wtr</p> <p style="text-align: right;">FIRST REPORT</p> <p style="text-align: center;">9</p> <p style="text-align: right;">COMPLETED</p>

County Graham Elev. 2409
 Sec. 20 Twp. 10S Rge. 23W
 Company Stanolind Oil
 Farm Name Guy R. Dorman No. 4

TOPS	DEPTH	LOG	DATUM
Anh.	1967		
TP.			
H.	3632	1228	
Tr.	3656	1247	
Dg.			
Bl.			
L.	3672	1263	
K.C.			
B.K.C.	3914	1505	
Ce.			
C.			
M.			
M.			
K.			
Mz.			
Me.			
V.			
S.			
S.			
A.			
R.			
Pe.			
G.			
T.D.	3940		

Loc. in Sec. SW SE SE
 Geol. _____
 Contr. _____
 Pool Happy
 6-29-55
 FIRST REPORT
 COMPLETE
 No. 0

Date Comm. 5/9/55
 8 5/8" 197 w/150 DST 3771-3809 op 1 hr Rec
 2160' SGCSW BHP 1170#, TSTD 2 BOPH no wtr
 1 hr, 16/3840-44, tstd 3 1/2 BOPH no wtr
 2 hrs, POP, BH Bomb 1492 BOPD no wtr

Co.
Lse.
No.
Sec.
T.
R.