

Graham

KANSAS


SECTION 20 TOWNSHIP 10 RANGE 23 W

WELL NO. #2 Walker

COMPANY ~~Heathman & Seeligson~~

*Walters & Selig*

NORTH

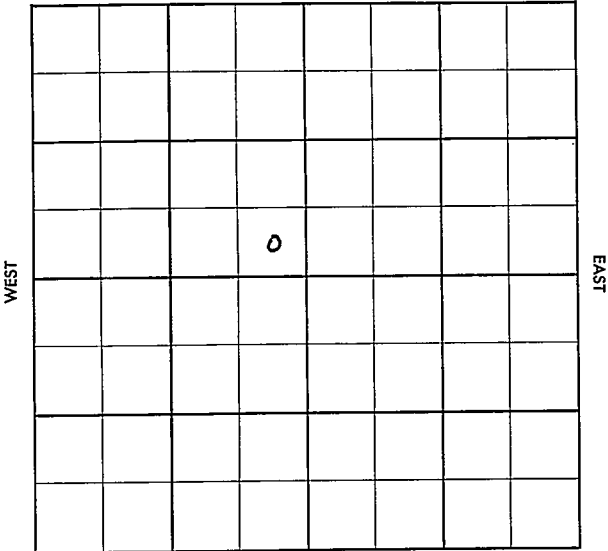

SOUTH

Graham

KANSAS

SEC. 20	TWP. 10	R. 23W
------------	------------	-----------

WELL NO. #2 Walker FARM

COMPANY ~~Heathman & Seeligson~~ *Walters Drlg.*

CONTRACTOR Walters

Happy


\_\_\_\_\_ Ft. from N. Line

\_\_\_\_\_ Ft. from S. Line

\_\_\_\_\_ Ft. from E. Line

\_\_\_\_\_ Ft. from W. Line

## SE SE NW

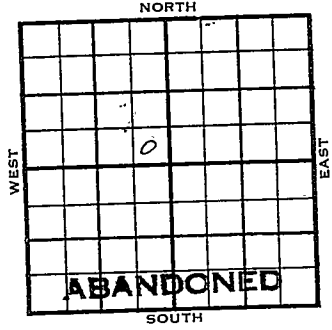

1956	ELEVATION 2395 KB	REPORT
------	----------------------	--------

1-25  
 Comm. 1-18-56  
 8" @ 186/100  
 Drlg. 3085  
 Anh. 1942

County Graham Elev. 2395 KB  
 Sec. 20 Twp. 10 Rge. 23W  
 Company Heathman & Seeligson  
 FarmName Walker No. 2

TOPS	DEPTH	LOG	DATUM	Loc. in Sec.
Anh.	<u>1942</u>			<u>SE SE NW</u>
Tr.				
H.				
Tr.				
Dg.				
Bl.				
L.				Geol. _____
K.C.				Contr. _____
B.K.C.				<u>Walters</u>
Ce.				<u>Pool</u>
C.				<u>Nappy</u>
M.				<u>JAN 25 '56</u>
M.				<u>0</u>
K.				
Mz.				
Me				
V.				
S.				
S.				
A.				
R.				
Pe.				
G.				<u>FIRST REPORT</u>
T.D.				

Date Comm. 1-18-56  
8" @ 186/100 drlg. 3085

Co.

Sec.

No.

Sec.

T.

R.

# CORRECTION

FORM B13 REV. SUNRA

County Graham Elev. 2395 KB  
 Sec. 20 Twp. 10 Rge. 23W  
 Company Hartman & Sealigson *Walters Drlg*  
 Farm Name Walker No. 2

TOPS	DEPTH	LOG	DATUM	Loc. in Sec.
	1912			SE SE NW
Arh.				
Tp.	3655			
H.				
Tr.				
Dg.				
Bl.				
L.	✓ 3691		1296	Geol.
K.C.				
BXC.	3925		1530	Conts
Ce.	Marm 4029		1634	Walters
C.	Base Marm 4070		1675	
M.	29 ✓ 4159		1764	Exp.
M.				Happy
K.				
Mz.				
Mo.				
V.				
S.				
A.				
R.				
PE.				
G.				
SD.	4180			ABANDONED

Date Comm. 1-18-56 MAR 7 1956  
 8" @ 186/100 drlg. 3085 FEB 1 '56 DST  
 3848 66 1hr 730' CIR run  
 225' oil + 60' OCM + 300' Md  
 no BHP DST. 3866-86 Failed  
 DST 3868-3905 1hr R 1300' SW  
 no BHP @ 4140 FEB @ '56 5 1/2 3927  
 1150 FEB 15 '56 WOST FEB 22 '56 L  
 FEB 23 '56 CO 22/3850-58 FU 1600'  
 Wtr 14 hrs 509. MAR 7 '56 REPF

32/3850-58 A FU 1650'  
SW  $\phi$  37 Bwph 2 hrs

R & Q

R.G.

MAR 19 1956