

Graham

KANSAS

20

10


23W

SECTION \_\_\_\_\_ TOWNSHIP \_\_\_\_\_ RANGE \_\_\_\_\_

WELL NO. #1 Walker "A"

COMPANY Imperial

NORTH

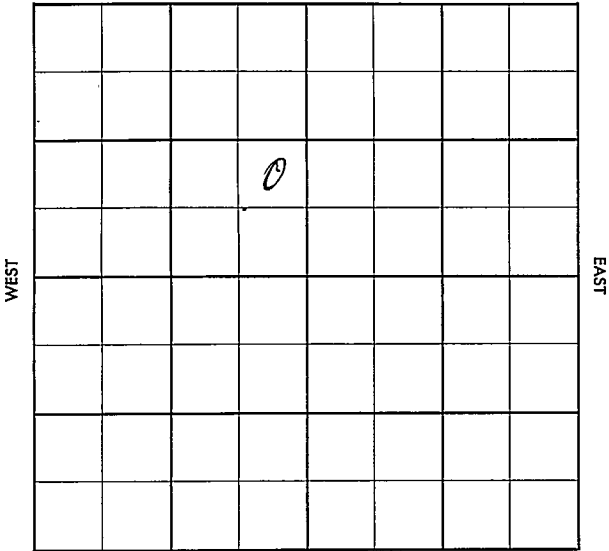

SOUTH

WEST

EAST

Graham

KANSAS

SEC.	20	TWP.	10	R.	23W
------	----	------	----	----	-----

WELL NO. #1 Walker "A" FARM

COMPANY Imperial

CONTRACTOR Harms-Burt Tools


Diebolg

\_\_\_\_\_ FT. FROM N. LINE

\_\_\_\_\_ FT. FROM S. LINE

\_\_\_\_\_ FT. FROM E. LINE

\_\_\_\_\_ FT. FROM W. LINE

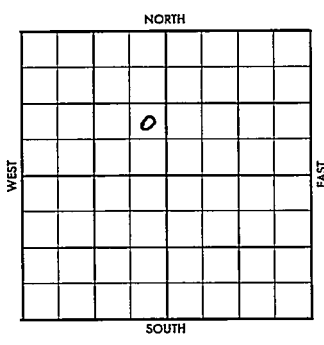

NE SE NW

1956	ELEVATION	REPORT
------	-----------	--------

9-5 Spud 8-30-56  
8" @ 195 w/150  
Drlg 3400

**ABANDONED**

County Graham Elev. 2410 RB  
 Sec. 20 Twp. 10 Rge. 23W  
 Company Imperial  
 Farm Name Walker "A" No. 1

TOPS	DEPTH	LOG	DATUM
Anh.	1975		
Ip.			
H.			
Tr.			
Dg.			
Bl.			
L.			
K.C.			
B.K.C.			
Ce.			
C.			
M.			
M.			
K.			
Mz.			
Me.			
V.			
S.			
S.			
A.			
R.			
PE.			
G.			
T.D.			

Loc. in Sec. NE SE NW  
 Geol.   
 Contr. HAPPY  
Harms-Burt  
 Tools   
 Pool   
Diebolt

	0	

FIRST REPORT  
 SEP 5 '56

Date Comm. 8/30/56, 8" @ 195 w/150, Drlg. 3400

*[Handwritten signature and scribbles]*

Co.  
 Sec.  
 No.  
 Sec.  
 T.  
 R.

County Graham Elev. 2410 RB  
 Sec. 20 Twp. 10 Rgs. 23W-10S  
 Company Imperial  
 Farm Name Walker "A" No. 1

TOPS	DEPTH	LOG	DATUM	Loc. in Sec.																														
Anh.	1975			VL SE BK																														
Tp.																																		
H.	3681	3680																																
Tr.	3700	3701																																
Dg.																																		
Bl.																																		
L.	3716	3714		Geol.																														
K.C.				Contr.																														
B.K.C.				Paris-Burt																														
Ce.				TO 13																														
C.				Pool																														
M.				Diebolt																														
M.				<table border="1"> <tr><td></td><td></td><td></td></tr> <tr><td></td><td>o</td><td></td></tr> <tr><td></td><td></td><td></td></tr> <tr><td colspan="3" style="text-align: center;">ABANDONED</td></tr> <tr><td></td><td></td><td></td></tr> <tr><td></td><td></td><td></td></tr> <tr><td></td><td></td><td></td></tr> <tr><td></td><td></td><td></td></tr> <tr><td></td><td></td><td></td></tr> <tr><td></td><td></td><td></td></tr> </table>					o					ABANDONED																				
	o																																	
ABANDONED																																		
K.																																		
Mz.																																		
Ma.																																		
V.																																		
S.																																		
S.																																		
A.																																		
R.																																		
PE.																																		
G.																																		
T.D.	3950			SEP 12 '50																														

Date Comm. 8/20/56, 3" @ 195 w/150, Drls. 340

SFP 12 '56 DST 3789-3804 1 hr. rec.  
750' wt. BITP 1300/20"  
DST 3875-91 30" rec 5' Md  
no press DST 3849-91 2 hrs  
150' MW BITP 910/

DEW