


Section 20 Township 10 Range 23 W

Well No. # 3 C. Brown

Company Mid-Cont. Petr. Corp.

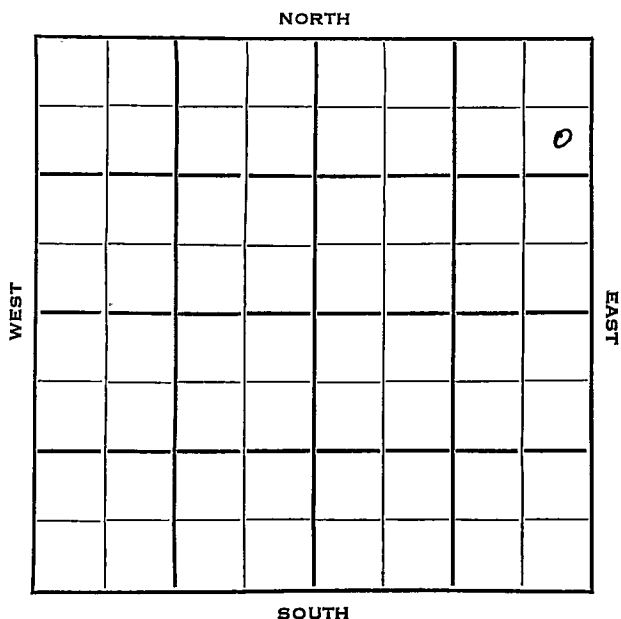

HOT FILE

Graham

KANSAS

SEC.

TWP.

R.

20

10 S

23 W

✓

WELL NO.

3 Celestin Brown

FARM

COMPANY

Mid-Cont. Petr. Corp.

CONTRACTOR

Gabbert-Jones

990

Happy Pool

Ft. from N. Line


Ft. from S. Line

330

Ft. from E. Line

Ft. from W. Line

SE NE NE

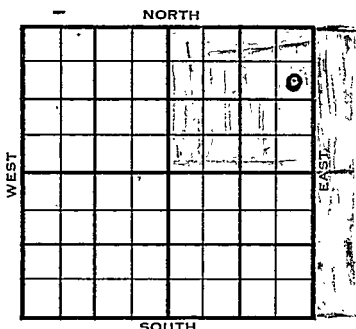

	ELEVATION	REPORT
1954	2387	
6/21	Location Notice	
6/21	Making location	(DR)
6/22	RUR (F.R. Ticket)	"
6/23	TD 260. Spud 6-21-54	
	10-3/4" @ 256 w/140 sax.	"
6/24	TD 260' WOC	"
6/25	Drlg 2050'. Top Anhy. 1945'	"
6/28	Drlg. 3205' Heeb 3615, Tor 3642,	"
6/29	Drlg. 3530' Lans 3652'	"
6/30	Drlg. 3700'	"
7/1	TD 3840'. DST 3812-40 open 30"	
	rec 460' oil.	"
7/2	TD 3892'. DST 3846-61 open 30";	
	rec 8' mud, 0 oil. Running	
	7" casing.	"
7/6	TD 3892'. 7" @ 3891 w/175 sax.	
	MIGT	"
7/7	Drlg. plugs. TD 3892'	"
7/8	TD 3892' Perforating	"
7/9	TD 3892' Perforating & testing.	"
7/12	TD 2893' Swbg. 15 BPH	"
7/13	TD 3892' Testing.	"
7/14	TD 3892' Taking potential.	"

DX-78

OVER

1954

7/15

TD 3892'

Comp. 7-14-54. Potential: 400 BPD
Pumping. Allowable 25 BPD. (DR)

7/17

State Pump Test - 397 BOPD (Ltr-McGehee)

7/22

Completed for a pumping potential
of 397 BOPD. (Ltr-McGehee)

7/21

Spdg 6-22-54

Oil well

TD 3892

10 3/8" @ 256

Anhy 1945 Heeb 3615 Tor. 3642

Lans. 3652

DST 3812-40 open $\frac{1}{2}$ hr. Rec. 460'
o & gcm 1060#

DST 3846-61 open $\frac{1}{2}$ hr. Rec. 8' mud
O#

TD 3892

7" @ 3891 CO to 3890 54/3826-35

FU 1025' oil 2500 A S/ 15 boph

Comp. 397 bopd

COMPLETED.

County Graham State Kansas
 Sec. 20 (Blk.) 10 (Sur.) 23W Map No.
 Operator Mid-Continent Petroleum Corp.
 Well No. 3 Farm C. Brown
 Elev. _____ Location SE NE NE



990 Ft. From N Line NE
330 Ft. From E Line Quarter

1st. Report JUN 23 1954

Completion _____

Remarks _____

Gabbert-Jones - Contr.


Spudding Date _____

Drlg. Data _____

Happy Pool

RUR

County Graham State Kansas
 Sec. 20 (Blk. 10) (Sur. 23W) Map No.
 Operator Mid-Continent Petroleum Corp.
 Well No. 3 Farm C. Brown
 Elev. 2387 Location SE NE NE

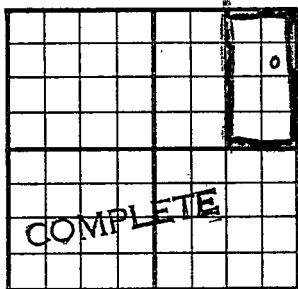

990 Ft. From N Line NE
330 Ft. From E Line Quarter
 1st. Report
 Completion JUL 21 1954
 Remarks Happy Pool
Gabbert-Jones - Contr.
 Spudding Date 6-22-54

Drlg. Data Oil well TD 3892

10 3/8" @ 256 Anhy 1945 Heeb. 3615

Tor. 3642 Lans. 3652 DST 3812-40

open 1/2 hr. Rec. 460' o & gcm 1060#

DST 3846-61 open 1/2 hr. Rec. 8' mud

O# TD 3892 7" @ 3891 CO to 3890


54/ 3826-35 FU 1025' oil 2500 A

S/ 15 boph Comp. 397 bopd

LOCATION NOTICE

TULSA, OKLA., June 21, 1954WELL NO. 3 ON Celestin Brown FARM

WILL BE AS FOLLOWS:

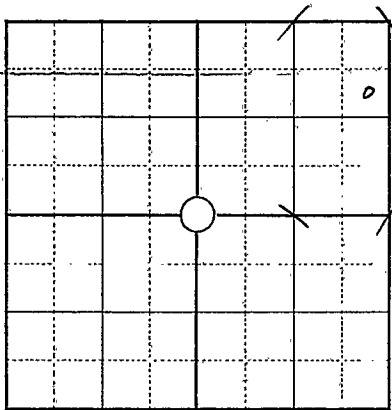

990 FEET FROM NORTH LINE

330 FEET FROM EAST LINE

FEET FROM SOUTH LINE

FEET FROM WEST LINE

IN E/2 NE/4SEC. 20 TWP. 10S RANGE 23WGraham COUNTY, STATE OF KansasREMARKS: R. L. Mankey; R. O. BobeyM. C. P. C. — 100%

COPIES TO:

R. W. McDOWELL
 DISTRICT SUPT.
 ACCOUNTING DEPT.
 SCOUTING DEPT.
 GEOLOGICAL DEPT.
 PIPE LINE DEPT.
 MATERIALS DEPT.
 RENTAL DEPT.
 LEGAL DEPT.
 LEO MEYER
 INCOME TAX DEPT.
 ENGINEERING DEPT.
 LEASE INVENTORY
 CLAIM DEPT.
 J. W. BASORE
 FILE

SIGNED A. E. Pierce

W

Card Typed - mm

3