


KANSAS

Sherman

Section 20 Township 10 Range 38W

Well No. #1 R. Cogswell

Company Sinclair-Prairie

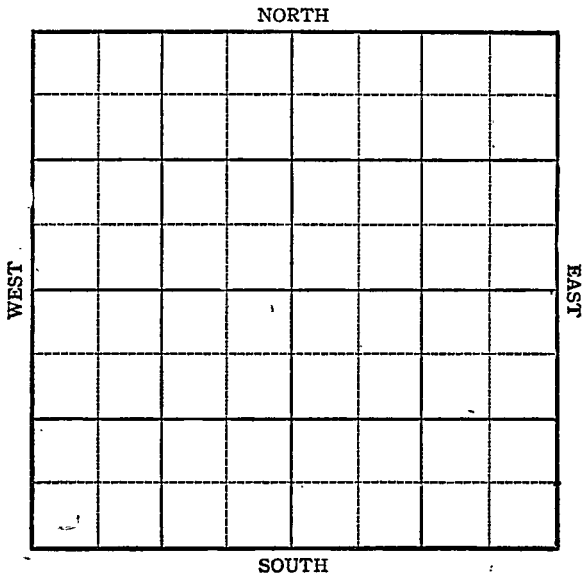

KANSAS

Sherman County

Sec. 20 Twp. 10 R. 38W

Well No. #1 R. Cogswell Farm

Sinclair-Prairie Company


Wildcat

 Ft. from N. Line

330 Ft. from S. Line

 Ft. from E. Line

330 Ft. from W. Line

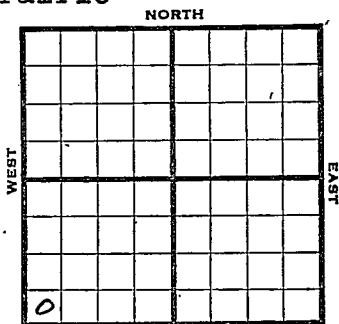

SW/c Elev. 3517

1944

R E P O R T

11/1 Location

11/8 "

11/16 "

11/24 "

11/29 RUR

12/6 "

12/14 "

12/21 "

12/29 13" @ 244

WOC

1945

1/3 Drlg 2415

1/10 Drlg 3160

1/17 8" @ 3570 WOC

1/26 Drlg. 4225'

1/31 Chase 3548'
Tarkio 4000
Howard 4088'
Shawnee 4190
Drlg. 4887'

2/7 Douglas 4363

Lans 4450

Drlg 5100

2/14 Drlg 5440

- OVER

1945

2/21 Miss. 4998
Arb. 5382
TD 5540'

ABANDONED

Pool Name Wildcat

Map No. N17 Sec. 20 Twp. 10 R. 38 W

Well No. I R. Cogswell

Sinclair-Prairie Company

FIRST REPORT

Contractor

SW/c

SECTION PLAT

_____ Ft. from N. Line

330 Ft. from S. Line

_____ Ft. from E. Line

330 Ft. from W. Line

Sherman

Location X

Rig up _____

Drilling and Remarks:

RECORD

Cased _____ in., _____ ft.

Sand _____

Gas _____

Oil _____

Total Depth _____

PRODUCTION

1st 24 hrs. Nat. _____

1st 24 hrs. after shot _____

Gas _____ Cu. Ft.

Dry Hole _____

Abandoned _____

Date

NOV 1 1944 19

S. J. LEWIS Scout

