

Well No. 1- Norman Farm  
Dulki Oil Company

NORTH

C						

13

WEST

EAST

SOUTH

Location.....

Rig Up.....

Drilling Remarks

Drilling Remarks

## RECORD

Cased..... in..... ft.  
 Sand.....  
 Gas.....  
 Oil.....  
 Total Depth.....

## PRODUCTION

1st 24 hrs. Nat.....  
 1st 24 hrs. after shot.....  
 Gas..... cu. ft.  
 Dry Hole.....  
 Abandoned.....

Map No. .... Sec. .... Twp. .... R. ....

Well No. .... Farm


..... Company

..... Ft. from N. Line

..... Ft. from S. Line

..... Ft. from E. Line

..... Ft. from W. Line

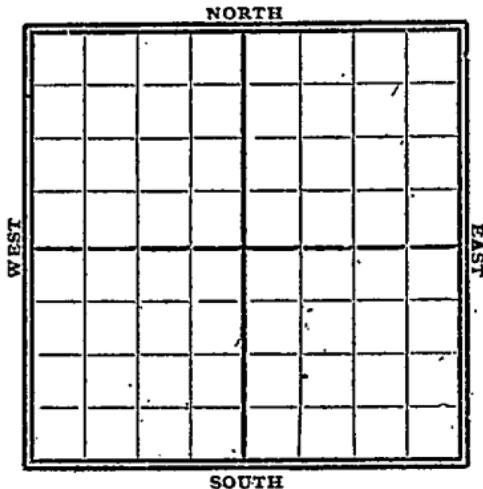

1924

Date

REPORT

*Gypsy Records*

"1/14

*Adv 703420'*

MAP No. 1 SEC. 20 TWP. 10S R. 11WWELL No. 1 DomarDelhi oil COMPANY

CONTRACTOR

## SECTION PLAT


0

FT. FROM N. LINE  
 FT. FROM S. LINE  
 FT. FROM E. LINE  
 FT. FROM W. LINE

LOCATION \_\_\_\_\_

RIG UP \_\_\_\_\_

## DRILLING AND REMARKS:

## RECORD

CASED \_\_\_\_\_ IN. \_\_\_\_\_ FT.

SAND \_\_\_\_\_

GAS \_\_\_\_\_

OIL \_\_\_\_\_

TOTAL DEPTH 34570

## PRODUCTION

1ST 24 HRS. NAT. \_\_\_\_\_

1ST 24 HRS. AFTER SHOT \_\_\_\_\_

GAS \_\_\_\_\_ CU. FT.

DRY HOLE ABANDONED 

DATE

01/14 1924 SCOUT