


Section 20 Township 10 Range 19W

Well No. #1 Berland

Company Derby Oil Co.

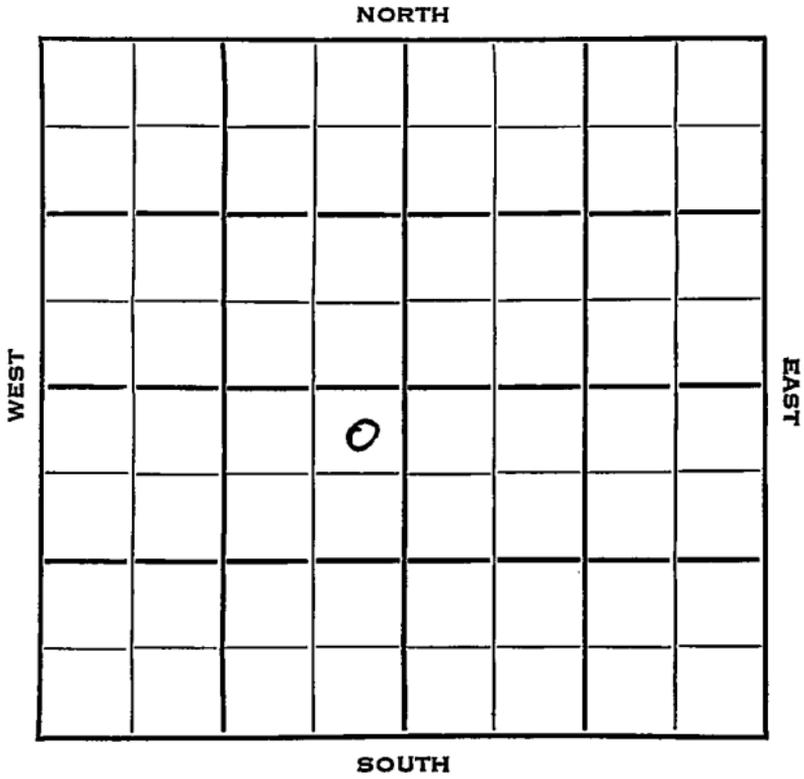

Sec. 20 Twp. 10 R. 19W

Well No. #1 Berland Farm

Derby Oil Co. Company

Peel Contractor

Wildcat


330 Ft. from N. Line

Ft. from S. Line

330 Ft. from E. Line

Ft. from W. Line

NE NE SW

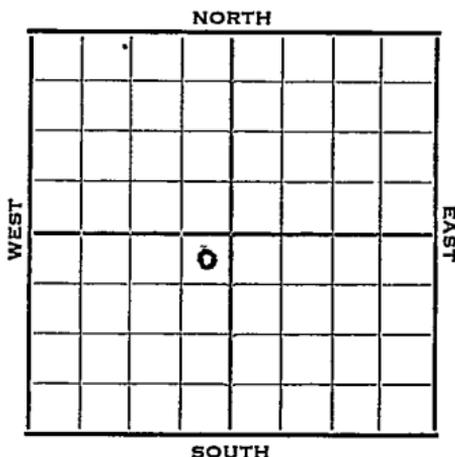

1953 2198' Elev. REPORT

- 7/14 Location
- 7/22 8" @ 214 w/150
Drlg. 2975
- 7/29 Heeb 3403, Lans 3444, Cong 3687½
Simp 3726, Arb 3769
DST 3771-77, 1 hr., 60' mcsw + SSO
945#
DST 3778-82, RTD, 1 hr., 150' hly
ocm, 30% oil, 1040#
5" @ 3778'
- 8/5 RUST
- 8/12 CO 3782 S/11½ BO & 8-¾ BW 4 hrs
S/6 BO & 18 BW 4 hrs 500 A
S/4 BO & 19½ BW 1 hr S/5-¾ BO
& 17 BWP 5 hrs.
- 8/19 NR
- 9/9 "
- 9/23 NR
- 10/7 NR
- 10/14 NR
- 10/21 "
- 11/4 NR
- 11/11 "

OVER

1953

11/18

No report

12/16

Spud 7-16-53 Oil well TD 3782'
8" @ 214 Heeb 3403' Lans. 3444'
Cong. 3687' Simp. 3726' Arb. 3769
DST 3771-77 open 1 hr rec 50' MCW
& SSO 945#
DST 3778-82, open 1 hr. rec 150' HOCM
50% oil 1040# 5" @ 3778 CO to
3782' S/11 $\frac{1}{2}$ BO 8-3/4 BW 4 hr.
S/6 BO 18 BW 4 hr. 500 A S/4 BO
19 $\frac{1}{2}$ BW 1 hr. S/3-3/4 BO 17 BWPH 5 hr.
P/49 BO 369 BWFD
Comp. 27 BOPD 90% wtr.

COMPLETED


County Rooks State Kansas

Sec. 20 (Blk. Twp.) 10 (Sur. Rge.) 19W Map No.

Operator Derby Oil Co.

Well No. 1 Farm Berland

Elev. _____ Location NE NE SW

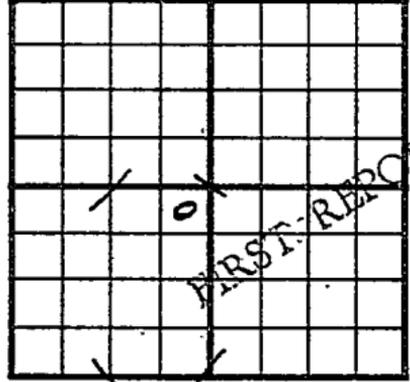

330 Ft. From N Line SW

330 Ft. From E Line Quarter

1st. Report JUL 14 1953

Completion _____

Remarks _____

Pool - Centr.

Spudding Date _____

Drlg. Data Wildcat

J. G. McGEHEE


County _____ Rooks State Kansas

Sec. 20 (Blk.) 10 (Sur.) 19W Map No. _____

Operator Derby Oil

Well No. 1 Farm Berland

Elev. 2198 Location NE NE SW

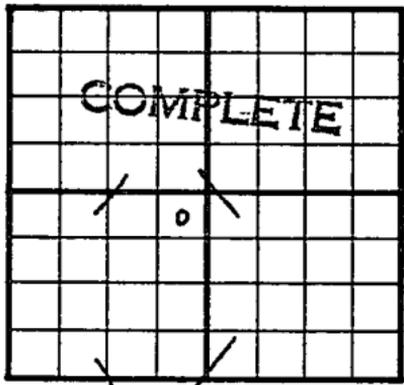

330Ft. From N Line SW

330Ft. From E Line Quarter

Ist. Report _____

Completion DEC 16 1953

Remarks Wildcat

Peel - Contr.

Spudding Date 7-16-53

Drlg. Data Oil well TD 3782

8" @ 214 Heeb. 3403 Lans. 3444

Cong. 3687 Simp. 3726 Arb. 3769

DST 3771-77 open 1 hr. Rec. 50' mcw

& SSO 945# DST 3378-82 open 1 hr.

Rec. 150' hocm 50% oil 1040#

5" @ 3778 CO to 3782 S/ 11½ bo

8 3/4 bw 4 hr. S/ 6 bo 18 bw 4 hr.

500 A S/ 4 bo 19½ bw 1 hr. S/ 3 3/4 bo

17 bwph 5 hr. P/ 49 bo 369 bwpd

Comp. 27 bopd 90% wtr.