


SECTION 20 TOWNSHIP 10 RANGE 20W

WELL NO. #1 Scoenthaler "A"

COMPANY D.G. Hansen

NORTH § C E $\frac{1}{2}$ SE SW

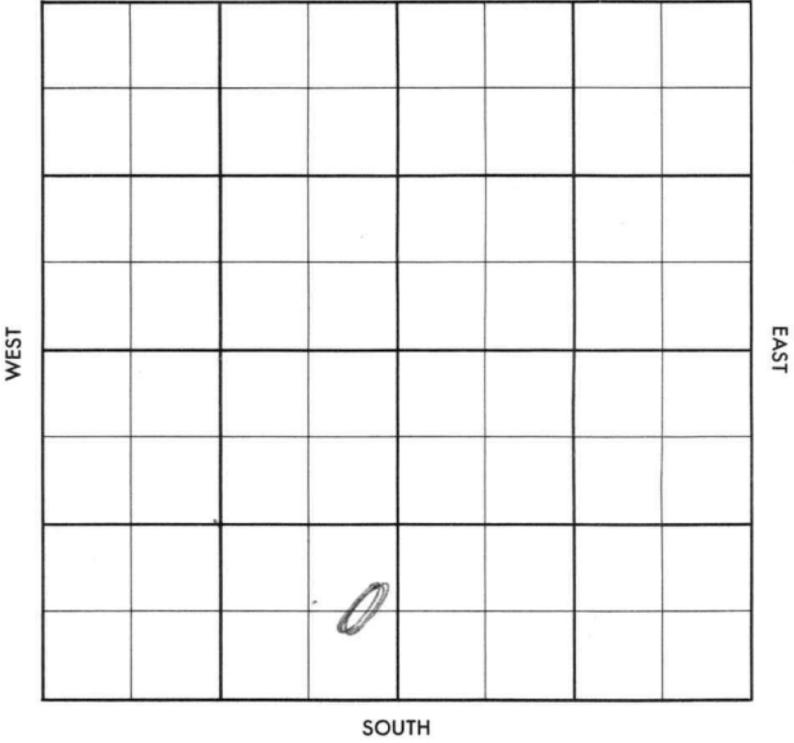

| | | |
|------|------|------|
| SEC. | TWP. | R. |
| 20 | 10 S | 20 W |


WELL NO. # 1 Scoenthaler ⁶⁶ "A"

FARM

COMPANY D. G. Hansen

CONTRACTOR C & G
Trico

_____ FT. FROM N. LINE
 _____ FT. FROM S. LINE
 _____ FT. FROM E. LINE
 _____ FT. FROM W. LINE

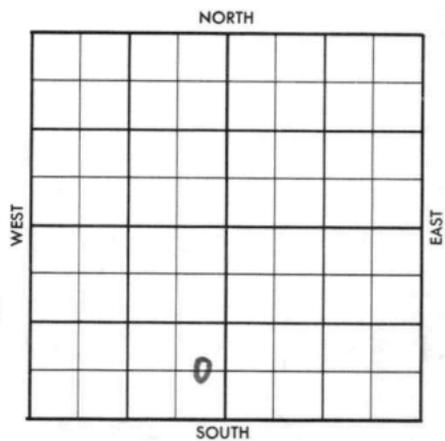

C E/2 SE SW

SDX-1/8 Mile

| | | |
|------|-----------|--------|
| 1957 | ELEVATION | REPORT |
|------|-----------|--------|

6/19

Comm. 6-16-57
 8" @ 163/150 WOC

(FR Tkt)

FEB 05 1958
M.M.


FORM 513 SUNRAY

County Rooks Elev. _____
 Sec. 20 Twp. 10 Rge. 20W
 Company D. G. Hansen
 Farm Name Scoenthaler No. 1

| TOPS | DEPTH | LOG | DATUM | Loc. in Sec. |
|--------|-------|-----|-------|--------------------------|
| Anh. | | | | C E $\frac{1}{2}$ SE SW |
| TP. | | | | |
| H. | | | | Geol. _____ |
| Tr. | | | | Contr. _____ |
| Dg. | | | | C & G |
| Bl. | | | | Pool |
| L. | | | | Trico |
| K.C. | | | | SDX - $\frac{1}{8}$ mile |
| B.K.C. | | | | |
| Ce. | | | | FIRST REPORT |
| C. | | | | JUN 19 57 |
| M. | | | | q |
| M. | | | | |
| K. | | | | |
| Mz. | | | | |
| Ma. | | | | |
| V. | | | | |
| S. | | | | |
| A. | | | | |
| R. | | | | |
| PE. | | | | |
| G. | | | | |
| T.D. | | | | |

Date Comm. 6-16-57
8" @ 163/150 WOC

Co.
Lse.
No.
Sec.
T.
R.

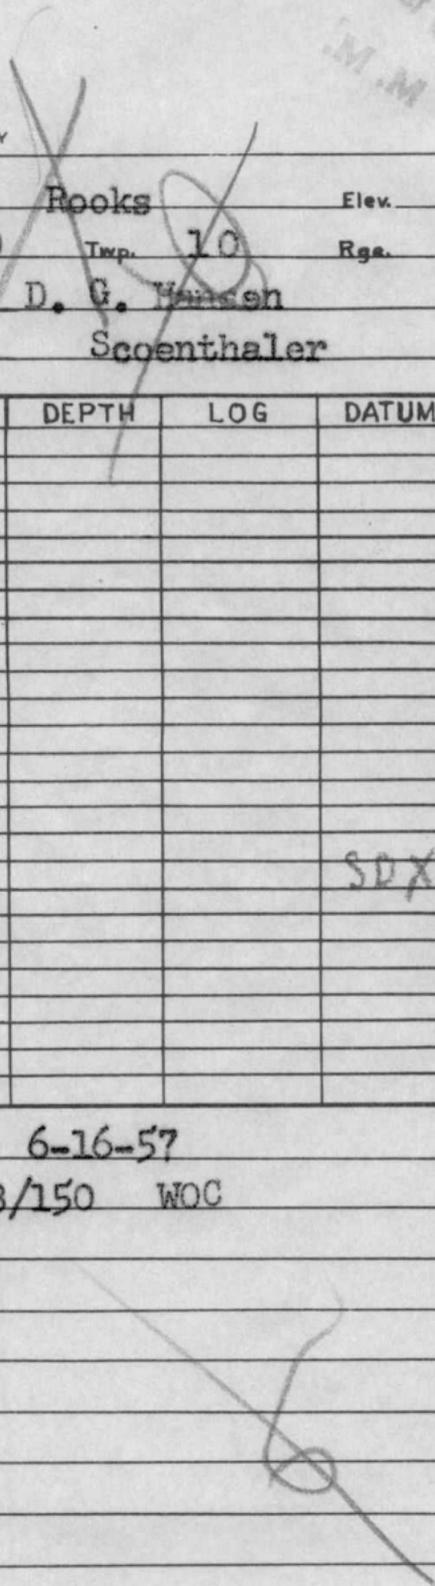

Co.

County Rocks Elev. 2171 DF

Sec. 20 Twp. 10 Rge. 20W

Company G. J. Hansen
 Name cosuthaler "A" No. 1

| | DEPTH | LOG | DATUM | Loc. in Sec. |
|--------|--------|-----|-------|------------------------|
| J | 1640 | | | C E ¹ SE SW |
| H | 3222 | | | |
| Tr | 3426 | | | |
| Dg | 3447 | | | |
| BL | | | | |
| L | → 3465 | | | Geol. |
| K.C. | | | | |
| B.K.C. | 3690 | | | Contr. |
| Ce. | | | | |
| C. | 3746 | | | C & G |
| M. | | | | |
| M. | | | | Pool |
| K. | | | | Trico |
| M.L. | | | | |
| Mo. | | | | |
| V. | | | | |
| S. | | | | |
| S. | | | | |
| A | | | | |
| R. | | | | |
| PE | | | | |
| G. | | | | |
| TR | 3825 | | | |

Lse.

No.

Sec.

T.

R.

JUL 3 '57
 1/8 mile
 ABANDONED

Date Comm. 6-16-57
8" @ 163/150 WOC JUL 1957 17 38/8

D & A