
FORM 51 Graham KANSAS

Section 20 Township 10 Range 22 W

Well No. # 1 C. Dreiling

Company Aurora Gasoline

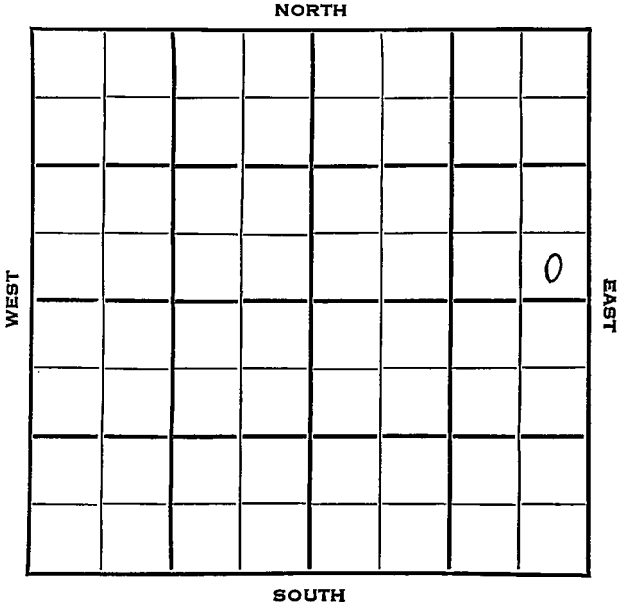

Graham KANSAS

SEC.	TWP.	R.
20	10	22 W

WELL NO.

1 C. Dreiling FARM


COMPANY

Aurora Gasoline

CONTRACTOR

Don Johnston

Wildcat

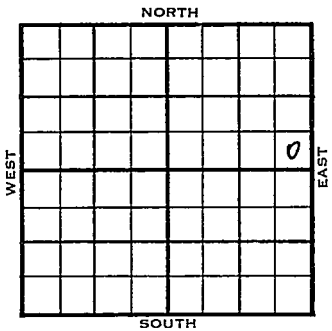

_____ Ft. from N. Line

330 Ft. from S. Line

330 Ft. from E. Line

_____ Ft. from W. Line

SE SE NE

Magnolia - AC

Champlin-NCRA-Amerada - DHM

ELEVATION 2325'

1954	REPORT
2/3	Spud 1-28-54 8" @ 173 Anhy 1838' Drlg. 2303'
2/10	Lans 3605' Drlg.3625'
2/17	B KC 3832 Drlg. 3917'
2/24	Spud 1-28-54 D&A TD 4070' 8" @ 173' Anhy 1838', Lans 3605', B KC 3832', Cong 3971', Arb. 4045' TD 4070' D&A

ABANDONED

DX-78

FORM 275 FOR SALE BY KANSAS BLUE PRINT CO.


County Graham State Kansas

Sec. 20 (Blk. Twp.) 10 (Sur. Rge.) 22W Map No.

Operator Aurora Gasoline

Well No. 1 Farm C. Dreiling

Elev. Location SE SE NE

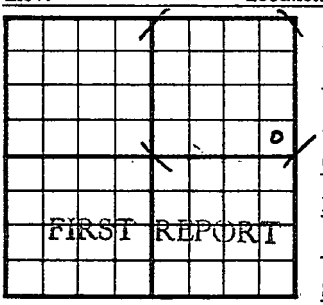

330 Ft. From S Line NE

330 Ft. From E Line Quarter

1st. Report FEB 3 1954

Completion

Remarks Magnolia - AC
Champlin-NCRA-Amerada
DHM
Don Johnston - Contr.

Spudding Date 1-28-54

Drlg. Data Wildcat

8" @ 173 Anhy 1838 drlg. 2303

J. G. McGEHEE

FORM 275 FOR SALE BY KANSAS BLUE PRINT CO.


County Graham State Kansas

Sec. 20 (Blk. Twp.) 10 (Sur. Rge.) 22W Map No.

Operator Aurora Gasoline

Well No. 1 Farm C. Dreiling

Elev. 2325 Location SE SE NE

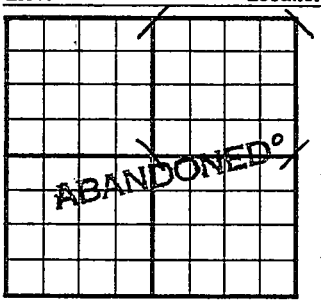

330 Ft. From S Line NE

330 Ft. From E Line Quarter

1st. Report

Completion FEB 24 1954

Remarks Wildcat

Don Johnston - Contr.

Spudding Date 1-28-54

Drlg. Data D & A TD 4070

8" @ 173 Anhy 1838 Lans. 3605

B KC 3832 Cong. 3971 Arb. 4045

TD 4070

D & A

J. G. McGEHEE