

STATE CORPORATION COMMISSION OF KANSAS
OIL & GAS CONSERVATION DIVISION
WELL COMPLETION OR RECOMPLETION FORM
ACO-1 WELL HISTORY
DESCRIPTION OF WELL AND LEASE

Operator: License # 6417
Name Union Pacific Resources Company
Address 1400 Smith Street, Suite 1500
City/State/Zip Houston, TX 77002

Purchaser N/A

Operator Contact Person Marilyn Day
Phone (713) 654-2758

Contractor: License # 5302
Name Red Tiger Drilling Company

Wellsite Geologist N/A
Phone

Designate Type of Completion
☒ New Well ☐ Re-Entry ☐ Workover
☐ Oil ☐ SWD ☐ Temp Abd
☐ Gas ☐ Inj ☐ Delayed Comp.
☒ Dry ☐ Other (Core, Water Supply etc.)

If ONWO: old well info as follows:

Operator
Well Name
Comp. Date Old Total Depth

WELL HISTORY

Drilling Method:
☒ Mud Rotary ☐ Air Rotary ☐ Cable
6/17/87 6/22/87 6/23/87
Spud Date Date Reached TD Completion Date
3,900'
Total Depth PBTD

Amount of Surface Pipe Set and Cemented at 261 feet
Multiple Stage Cementing Collar Used? Yes ☒ No
If yes, show depth set feet
If alternate 2 completion, cement circulated
from feet depth to w/ SX cmt
Cement Company Name
Invoice #

API No. 15-163-22,929

County Rooks

50°N NW/4 SE/4 Sec. 1 Twp. 10S Rge. 20W East
..... West

1040 Ft North from Southeast Corner of Section
915 Ft West from Southeast Corner of Section
(Note: Locate well in section plat below)


Lease Name Sutor "A" Well # 22

Field Name Marcotte

Producing Formation

Elevation: Ground 2233' KB 2238'

Section Plat

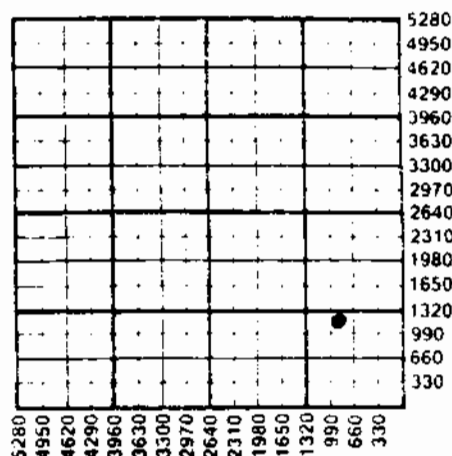

WATER SUPPLY INFORMATION

Disposition of Produced Water: Disposal
Docket # Repressuring

Questions on this portion of the ACO-1 call:

Water Resources Board (913) 296-3717

Source of Water:

Division of Water Resources Permit #

Groundwater Ft North from Southeast Corner
(Well) Ft West from Southeast Corner of
Sec Twp Rge East West

☒ Surface Water Ft North from Southeast Corner
(Stream, pond etc) Ft West from Southeast Corner
Sec Twp Rge East West

Charles Stahl, Zurich, KS 67676

Other (explain)
(purchased from city, R.W.D. #)

INSTRUCTIONS: This form shall be completed in triplicate and filed with the Kansas Corporation Commission, 200 Colorado Derby Building, Wichita, Kansas 67202, within 120 days of the spud date of any well. Rule 82-3-130, 82-3-107 and 82-3-106 apply.

Information on side two of this form will be held confidential for a period of 12 months if requested in writing and submitted with the form. See rule 82-3-107 for confidentiality in excess of 12 months.

One copy of all wireline logs and drillers time log shall be attached with this form. Submit CP-4 form with all plugged wells. Submit CP-111 form with all temporarily abandoned wells.

Operator Name Union Pacific Resources Company Lease Name Sutor Well # A-22

Sec. 1 Twp. 10S Rge. 20W ☐ East ☒ West County Rooks

WELL LOG

INSTRUCTIONS: Show important tops and base of formations penetrated. Detail all cores. Report all drill stem tests giving interval tested, time tool open and closed, flowing and shut-in pressures, whether shut-in pressure reached static level, hydrostatic pressures, bottom hole temperature, fluid recovery, and flow rates if gas to surface during test. Attach extra sheet if more space is needed. Attach copy of log.

Drill Stem Tests Taken ☐ Yes ☒ No
 Samples Sent to Geological Survey ☒ Yes ☐ No
 Cores Taken ☐ Yes ☒ No

Formation Description

☒ Log ☐ Sample

Name	Top	Bottom
Hubner		3344
Lecompton		3346
Oread		3384
Toronto		3464
Lansing		3484
Kansas City		3552
Marmaton		3728
Arbuckle		3852

CASING RECORD ☒ New ☐ Used

Report all strings set-conductor, surface, intermediate, production, etc.

Purpose of String	Size Hole Drilled	Size Casing Set (in O.D.)	Weight Lbs/Ft.	Setting Depth	Type of Cement	#Sacks Used	Type and Percent Additives
Surface	12-1/4"	8-5/8"	24#	260'	Common	200	2% gel 3%CC

PERFORATION RECORD

Shots Per Foot	Specify Footage of Each Interval Perforated	Acid, Fracture, Shot, Cement Squeeze Record (Amount and Kind of Material Used)	Depth
.....			
.....			
.....			
.....			

TUBING RECORD	Size	Set At	Packer at	Liner Run	☐ Yes ☐ No
Date of First Production	Producing Method ☐ Flowing ☐ Pumping ☐ Gas Lift ☐ Other (explain).....				