

~~1-10-20W~~
1-10-20W

PLAT AND CERTIFICATION OF ACREAGE ATTRIBUTABLE TO A GAS WELL

CG-8

State Corporation Commission, Conservation Division
200 Colorado Derby Bldg. Wichita, Kansas 67202

OPERATOR Union Pacific Resources Company

LOCATION OF WELL

LEASE Sutor "A"

990 feet from the south line
2289 feet from the east line
Of the SE/4 of Sec. 1 T. 10S R. 20W

WELL NUMBER 23

FIELD Marcotte

COUNTY Rooks

ORDER GRANTING ALLOWABLE ENTERED IN DOCKET NO. _____


NUMBER OF ACRES

ATTRIBUTABLE TO WELL 10

DESCRIPTION OF ACREAGE:

PLAT

(Show location of Well and outline attributable acreage)

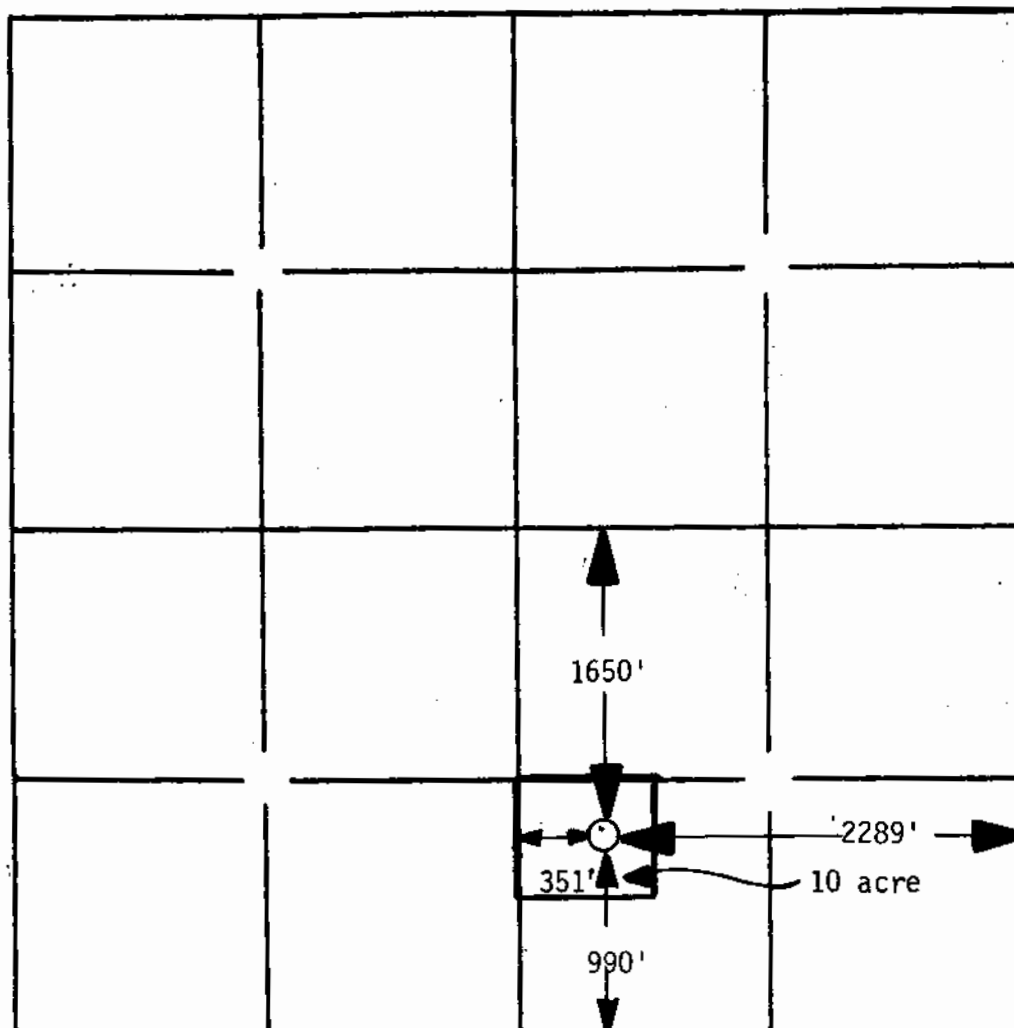

The undersigned hereby certifies that he is Regulatory Analyst
for Union Pacific Resources Company, a duly authorized agent, that all infor-