


WELL LOG BUREAU - KANSAS GEOLOGICAL SOCIETY
508 E. Lurdock, Wichita, Kansas

Company - E & R DRILLING, INC.
Farm - Hinkhouse No. 1

SEC. 6 T. 10 R. 20W
C&E 1/2 NE NE

Total Depth. 3940
Comm. 12-1-49 Comp. 12-17-49
Shot or Treated.
Contractor.
Issued. 1-14-50

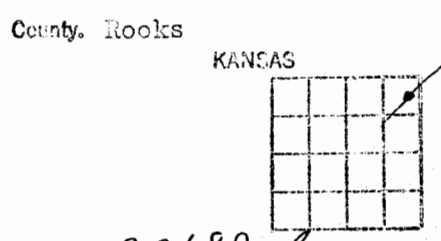

CASING:
8 5/8" 180 com. w/125 sx.

Elevation. 2268 *Ind.*

Production. Dry

Figures indicate Bottom of Formations.

- surface clay, sand 20
- sand, shale 100
- shale 740
- sand, shale 1145
- sand 1190
- shale, shells, sand 1290
- sand 1500
- red bed, shale 1680
- shale, lime 1795
- anhyd. 1823
- shale, red bed, shells 1910
- shale lime 2390
- lime, shale, pyrite 2405
- lime 2435
- shale, lime, shells 2450
- lime, shale 2520
- shale, shells pyrite 2545
- shale, lime 2585
- shale, shells 2640
- shells, lime, shale 2660
- lime, pyrite 2690
- lime, shale 2845
- shale 2935
- lime, shale 2985
- lime, shale, pyrite 3045
- lime, shale 3277
- lime 3358
- congl. 3940
- Total Depth

- Tops:
- Topeka 3283
 - Lansing 3550
 - Conglomerate 3853