


WELL LOG BUREAU - KANSAS GEOLOGICAL SOCIETY
508 E. Murdock, Wichita, Kansas

Company - FRANCIS OIL & GAS CO.
Farm - Wilson No. 2 or 3 (del 1)

SEC. 2 T. 10 R. 20W
SW NE NE

Total Depth. 3843
Comm. 5-18-50 Comp. 5-30-50
Shot or Treated.
Contractor. Veeder Supply & Development Co.
Issued. 7-8-50

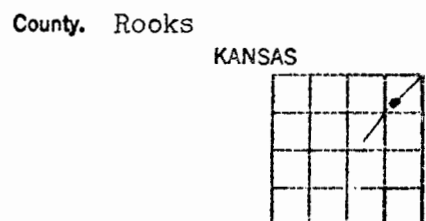

CASING:
8 5/8" 257' com. w/150 sx.

Elevation. 2231' Ind.

Production. Dry

Figures Indicate Bottom of Formations.

surface soil	30
gravel	50
sand, shale	170
shale, gravel	240
shale	252
shale, shells	880
sand, shale	1050
shale	1150
sand, shale	1425
red bed	1635
anhyd.	1720
red bed, shale, shells	1795
red bed	1875
salt, shale	1935
shale	2040
salt, shale	2110
shale, lime, shells	2215
lime, shale	2360
shale, shells	2510
lime, shale	2565
lime	2630
lime, shale	2830
shale, shells	2870
lime, shale	2975
shale, shells	3145
lime, shale	3330
lime	3525
lime, chert	3605
lime	3785
lime, chert	3817
chert	3843
Total Depth....	
Tops: Scout	
Lansing	3546
Congl.	3783