

32-10-20Wd

STATE CORPORATION COMMISSION OF KANSAS  
OIL & GAS CONSERVATION DIVISION  
WELL COMPLETION OR RECOMPLETION FORM  
ACO-1 WELL HISTORY  
DESCRIPTION OF WELL AND LEASE

Operator: License # 6412  
Name Sid Tomlinson  
Address P.O. Box 2369  
City/State/Zip Ketchum, Id 83340

Purchaser

Operator Contact Person Sid Tomlinson  
Phone 208-726-5741

Contractor: License # 5671  
Name Revlin Drils, Inc.

Wellsite Geologist Chuck Immich  
Phone 316-684-5500

Designate Type of Completion

New Well  Re-Entry  Workover  
 Oil  SWD  Temp Abd  
 Gas  Inj  Delayed Com  
 Dry  Other (Core, Water Supply etc.)

If OWWO: old well info as follows:  
Operator  
Well Name  
Comp. Date Old Total Depth

WELL HISTORY

Drilling Method:  
 Mud Rotary  Air Rotary  Cable

12-8-85 12-14-85 12-14-85  
Spud Date Date Reached TD Completion Date

3750 1600  
Total Depth PBSD

Amount of Surface Pipe Set and Cemented at 249 feet  
Multiple Stage Cementing Collar Used? Yes  No  
If yes, show depth set feet  
If alternate 2 completion, cement circulated from feet depth to w/SX cmt  
Cement Company Name Halliburton  
Invoice # 100753

API No. 15-163-22-809

County Rooks

N 1/2 NE SW NW Sec 32 Twp 10 Rge 20 East West

3795 Ft North from Southeast Corner of Section  
4200 Ft West from Southeast Corner of Section  
(Note: Locate well in section plat below)


Lease Name Mary Well # B.J.

Field Name

Producing Formation

Elevation: Ground 2120 KB 2125

Section Plat

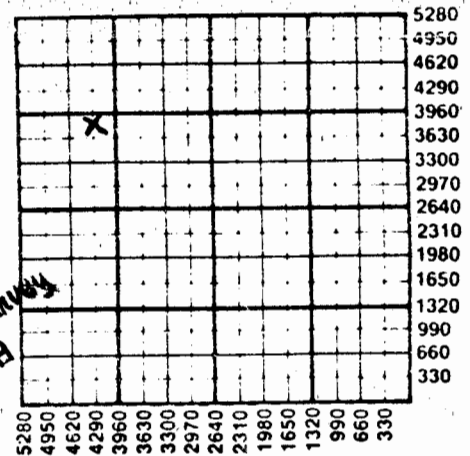

FEB 03 1986  
State Geological Survey  
WICHITA BRANCH

WATER SUPPLY INFORMATION

Disposition of Produced Water: Disposal  
Docket # Repressuring

Questions on this portion of the ACO-1 call:

Water Resources Board (913) 296-3717

Source of Water:  
Division of Water Resources Permit #

Groundwater Ft North from Southeast Corner  
(Well) Ft West from Southeast Corner of  
Sec Twp Rge East West

Surface Water Ft North from Southeast Corner  
(Stream, pond etc) Ft West from Southeast Corner  
Sec Twp Rge East West

Other (explain) farmers pond less than 15 acre  
(purchased from city, R.W.D. #)

INSTRUCTIONS: This form shall be completed in duplicate and filed with the Kansas Corporation Commission, 200 Colorado Derby Building, Wichita, Kansas 67202, within 90 days after completion or recompletion of any well. Rule 82-3-130 and 82-3-107 apply.  
Information on side two of this form will be held confidential for a period of 12 months if requested in writing and submitted with the form. See rule 82-3-107 for confidentiality in excess of 12 months.  
One copy of all wireline logs and drillers time log shall be attached with this form. Submit CP-4 form with all plugged wells. Submit CP-111 form with all temporarily abandoned wells.

WAS-01-SE

76442

SIDE TWO

Operator Name Sid Tomlinson Lease Name Mary R Well # 1

Sec 32 Twp 10 Rge 20 East West County Rooks

WELL LOG

INSTRUCTIONS: Show important tops and base of formations penetrated. Detail all cores. Report all drill stem tests giving interval tested, time tool open and closed, flowing and shut-in pressures, whether shut-in pressure reached static level, hydrostatic pressures, bottom hole temperature, fluid recovery, and flow rates if gas to surface during test. Attach extra sheet if more space is needed. Attach copy of log.

Drill Stem Tests Taken [X] Yes [ ] No
Samples Sent to Geological Survey [ ] Yes [X] No
Cores Taken [ ] Yes [ ] No

Formation Description
[ ] Log [ ] Sample

DST #1 3534-3622' (Lansing H,I,J,K)
30/45/45/60 Recovered 30' mud w/few oil specks.
FP 101/111 SIP 354/273

Table with columns: Name, Top, Bottom. Welex Gamma Guard Sidewall Neutron Log Electric Log Tops: Anhydrite 1583 (+ 537), Topeka 3165 (-1040), Heebner 3371 (-1246), Lansing 3409 (-1284), Base LKC 3634 (-1509), TD 3750 (-1625)

CASING RECORD [X] New [ ] Used
Report all strings set-conductor, surface, intermediate, production, etc.
PERFORATION RECORD
TUBING RECORD
Date of First Production Producing Method [ ] Flowing [ ] Pumping [ ] Gas Lift [ ] Other (explain)