

ELYSIUM ENERGY, LLC

Morel #8

NENESE Section 2 T9S R19W


Graham County, Kansas

Wellbore Schematic

9/11/03

Spud Date: 8/1/03
Completion Date: 8/15/03

3-10-214
1665
Ore
(rel) tech
10/19

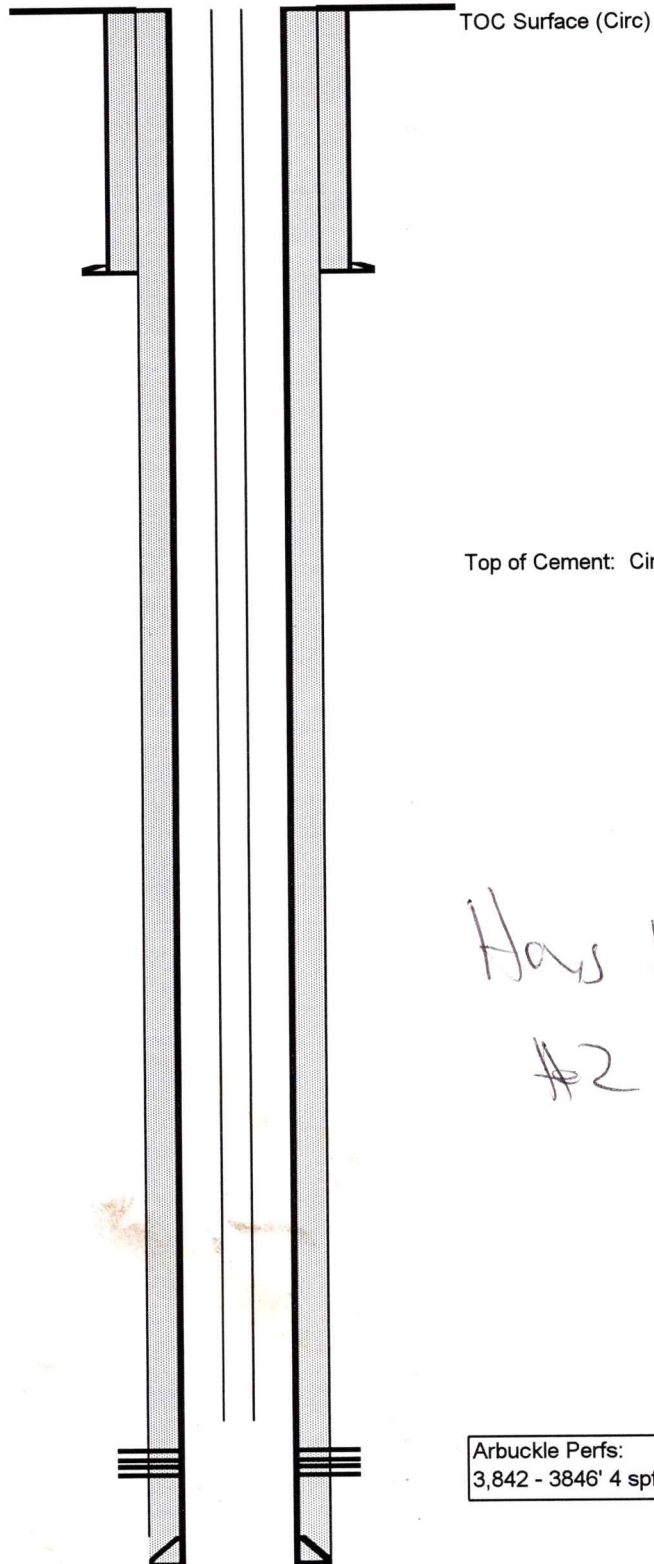

Surface Casing :

8 5/8", 23# set at 223.30'
Cemented with 150 sx

Tubing Detail:

128 jts 2 7/8"
SN at 3,864'

Production Casing:

5 1/2", 15.5#, set at 3,896.97'
Cemented with 525 sx