


Graham KANSAS

DX 78-1

Section 21 Township 10 Range 23W
 Well No. 1 Nemechek
 Company B & B Heathman

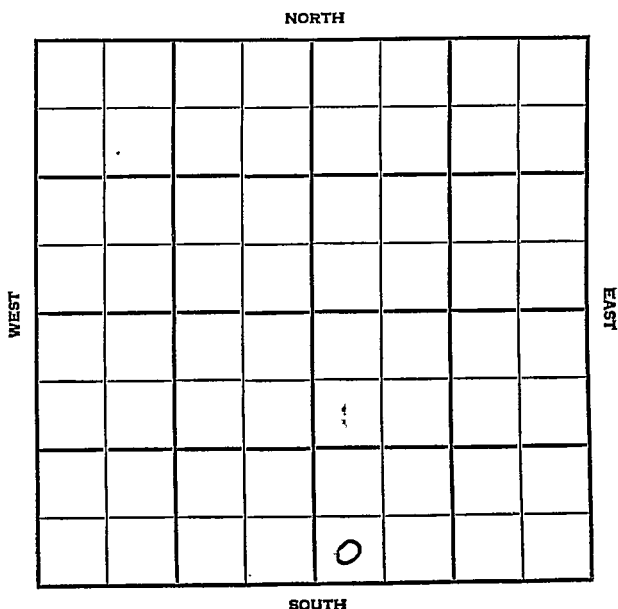

23 W

FARM

B & B & Heathman

CONTRACTOR

NORTH

Ft. from N Line

330

Ft. from S. Line

Ft. from E. Line

330

Ft. from W. Line

SW SW SE

SOUTH

ELEVATION

REPORT

1954

2376!

7/7

MIR

7/22

Top 3375' Heeb 3602' Tor. 3624'
Lans. 3637'

DST 3633-59 open 1/2 hr, rec 245' SW
830#

DST 3666-94, open 1/2 hr, rec 2300'
SGCSW, 1155#.

DST 3716-37 open $\frac{1}{2}$ hr rec 1500' SW,
1200#

DST 3772-81, open 1 hr rec 460' 0 &
GCSW, 840#

DST 3793-3808, open 20 min, rec 2200
gas, 1530' oil. 735#

DST 3833-46 open 1 hr rec 630' gas,
30' OCM 120# B KC 3872

TD 3890 5" @ 3890. (Ltr-McGehee)

8/11

WOP

9/8

Spud 7-7-54 Oil well TD 3890

8" @ 215 Top 3375 Heeb 3602

Tor. 3624 Lans 3637

DST 3633-59 open $\frac{1}{2}$ hr rec 245' SW
830#

DST 3666-94 open $\frac{1}{2}$ hr rec 2300' SGCSW
1155#

OVER

1954

9/8

(Information continued)

DST 3716-37 open $\frac{1}{2}$ hr rec 1500' SW
1200#

DST 3772-81 open 1 hr rec 460' O &
GCSW 840#

DST 3793-3808 open 1/3 hr. rec 2200' gas
1530' oil 735#

DST 3833-46 open 1 hr rec 630' gas
30' OCM 120# B KC 3872

TD 3890 5" @ 3890 24/3834-40

S/7 GOPH 1000 A S/3 BOPH 3 hr.


SP 3827 26/3814-24 S/25 GOPH

2000 A S/35 BOPH 3 hr.

Comp. 609 BOPD

COMPLETED

County Graham State Kansas
 Sec. 21 (Blk. 10) (Sur. 23W) (Twp. 10) Map No. _____
 Operator B & B & Heathman
 Well No. 1 Farm Nemechek
 Elev. _____ Location SW SW SE

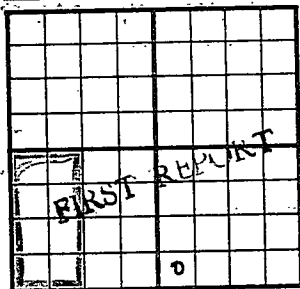

330 Ft. From S Line SE
330 Ft. From W Line Quarter

Ist. Report JUL 7 1954

Completion _____


Remarks _____

Spudding Date _____

Drlg. Data

M I R

J. G. McGEHEE

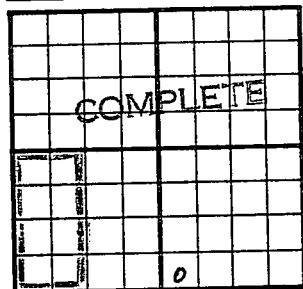County Graham State KansasSec. 21 (Blk. Twp.) 10 (Sur. Rge.) 23W Map No.Operator B & B & HeathmanWell No. 1 Farm NemechekElev. 2376 Location SW SW SE330 Ft. From S Line SE330 Ft. From W Line Quarter

1st. Report

Completion SEP 8 1954

Remarks

Spudding Date 7-7-54Drlg. Data Oil well TD 38908" @ 215 Top. 3375 Heeb. 3602Tor. 3624 Lans. 3637 DST 3633-59open $\frac{1}{2}$ hr. Rec. 245' sw 830#DST 3666-94 open $\frac{1}{2}$ hr. Rec. 2300' sgcsw1155# DST 3716-37 open $\frac{1}{2}$ hr. Rec.1500' sw 1200# DST 3772-81 open 1 hr.Rec. 460' o & gcsw 840# DST 3793-3808open $\frac{1}{3}$ hr. Rec. 2200' gas 1530' oil735# DST 3833-46 open 1 hr. Rec.630' gas 30' ocm 120# B KC 3872TD 3890 5" @ 3890 24/ 3834-40S/ 7 goph 1000 A S/ 3 boph 3 hr.SP 3827 26/ 3814-24 S/ 25 goph 2000 AS/ 35 boph 3 hr. Comp. 609 bopd

FABEN GILSTRAP