


DX 78-1

Section 21 Township 10 Range 23W

Well No. 3 Trexler

Company C. R. A.

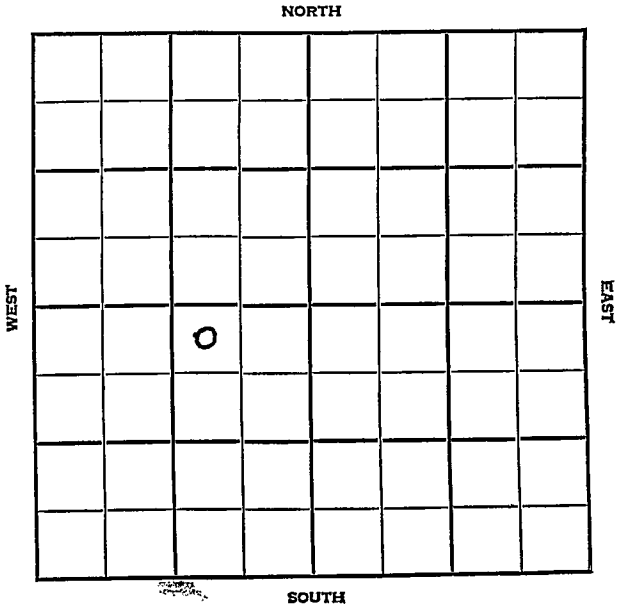

Graham KANSAS

SEC.	21	TWP.	10	R.	23W
------	----	------	----	----	-----

WELL NO. 3 Trexler FARM

COMPANY C R A

CONTRACTOR CRA
Happy Pool


330

_____ Ft. from N. Line

_____ Ft. from S. Line

990 _____ Ft. from E. Line

_____ Ft. from W. Line

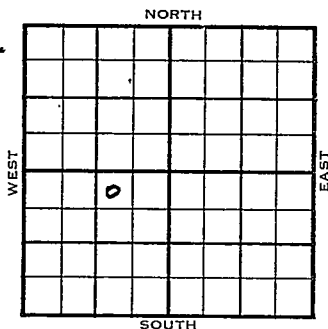

NW NE SW

1954	ELEVATION	REPORT
	2378	

8/4 Spdg 7-30-54
10" @ 235
Drlg. 2500

8/11 Heeb 3596', Tor 3615'
DST 3605-21', 1 hr., 210' gas, 65' gco, 975#
Lans 3632'
DST 3636-41', 1 hr., 90' gas, 15' oil, 345' SW, 1100#
DST 3799'-3805', 1 hr., 15' gas, 3270' oil
DST 3818-25', 1 hr., 270' gas, 20' gco 500#
DST 3826-47', 1 hr., 360' gas, 40' gcm, 500#
Drlg. 3865'

9/8 Spud 7-30-54 Oil well TD 3873
10" @ 235 Heeb 3596 Tor. 3615
DST 3605-21 open 1 hr rec 210' gas 65' GCO 975# Lans 3632
DST 3636-41 open 1 hr rec 90' gas, 15' oil 345' SW 1100#
DST 3799-3805 open 1 hr rec 15' gas 3270' clean oil
DST 3818-25 open 1 hr rec 270' gas 20' GCO 500#

1954
9/8

(Information continued)

DST 3826-47 open 1 hr rec 360' gas
40' GCO 500# TD 3873 5" @ 3872
Schl tops: Heeb 3598 Tor 3619
Lans 3635 B KC 3863 TD 3873
CO to 3847 32/3832-40 12/3822-25
16/3812-16 F/51 BO 1 hr.
F/21 BO 4 hr. 2000 A
Comp. BHB 2165 BOPD

COMPLETED

County Graham State Kansas

Sec. 21 (Blk. 10) (Sur. 23W) (Twp.) (Rge.) Map No.

Operator C R A

Well No. 3 Farm Trexler

Elev. 2378 Location NW NE SW

COMPLETE									

330 Ft. From N Line SW

990 Ft. From E Line Quarter

1st. Report

Completion SFP 8 1954

Remarks Happy Pool

CRA - Contr.

Spudding Date 7-30-54

Drlg. Data Oil well TD 3873

10" @ 235 Heeb. 3596 Tor. 3615

DST 3605-21 open 1 hr. Rec. 210' gas

65' gco 975# Lans. 3632 DST 3636-41

open 1 hr. Rec. 90' gas 15' oil

345' sw 1100# DST 3799-3805 open 1 hr.

Rec. 15' gas 3270' clean oil DST 3818-25

open 1 hr. Rec. 270' gas 20' gco 500#

DST 3826-47 open 1 hr. Rec. 360' gas

40' gco 500# TD 3873 5" @ 3872

SCHLUMBERGER TOPS

Heeb. 3598 Tor. 3619 Lans. 3635

B KC 3863 TD 3873 CO to 3847 32/ 3832-40

12/ 3822-25 16/ 3812-16 F/ 51 bo 1 hr.

F/ 21 bo 4 hr. 2000 A

Comp. BHB 2165 bopd

FABEN GILSTRAP