


Graham

DX 78-1

KANSAS

Section 21 Township 10 Range 23W
Well No. #4 Trexler
Company C R A

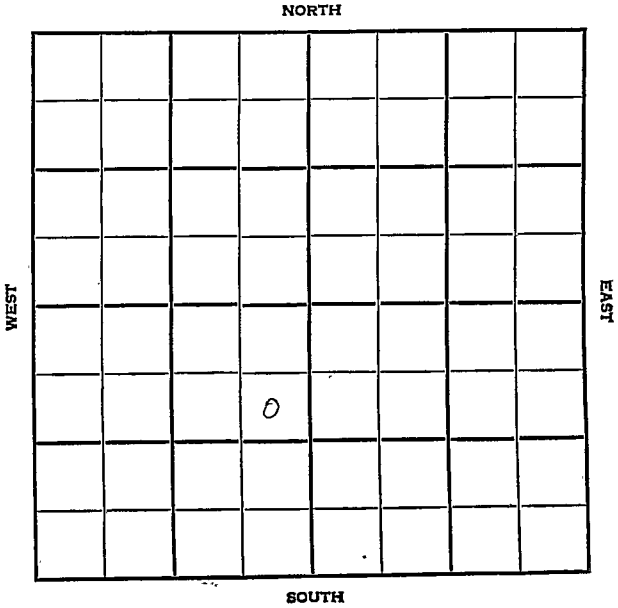

HOT FILE		Graham	KANSAS
SEC.	FILE	EMP.	R.
21	10	23 W	
WELL NO.			
# 1, Trexler			FARM
COMPANY			
C R A			
CONTRACTOR			
C R A			

Happy Pool		NORTH			
990	Ft. from N. Line				
	Ft. from S. Line				
330	Ft. from E. Line				
	Ft. from W. Line				
SE NE SW		SOUTH			

	ELEVATION	REPORT
1954	2366'	
8/25	Location	
9/15	Spud 8-27-54 D & A TD 3998 10" @ 235 Heeb 3599 Tor. 3619 Lans. 3633 DST 3797-3807 open 1 hr rec 35' mud O# DST 3813-26 open 1 hr rec 15' VSOQM O# DST 3833-46 open 1 hr rec 20' mud O# B KC 3864 Marm 3969 TD 3998' D & A	
ABANDONED		

County Graham State KansasSec. 21 (Blk. Twp.) 10 (Sur. Rge.) 23W Map No.Operator C R AWell No. 4 Farm TrexlerElev. Location SE NE SW990 Ft. From N Line SW330 Ft. From E Line Quarter1st. Report AUG 25 1954

Completion


Remarks

C R A - Contr.

Spudding Date

Drlg. Data Happy PoolLocation

FABEN GILSTRAP

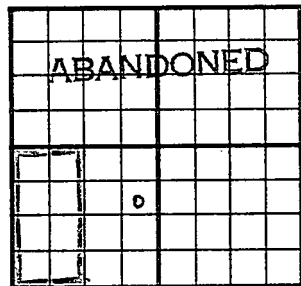County Graham State KansasSec. 21 (Blk. 10 (Sur. 23W Map No. 10) (Twp. 10 (Rge. 23W)Operator C R AWell No. 4 Farm TrexlerElev. 2366 Location SE NE SW990 Ft. From N Line SW330 Ft. From E Line Quarter

1st. Report

Completion SEP 15 1954Remarks Happy PoolCRA - Contr.Spudding Date 8-27-54Drlg. Data D & A TD 399810" @ 235 Heeb. 3599 Tor. 3619Lans. 3633 DST 3797-3807 open 1 hrRec. 35' mud 0# DST 3813-26open 1 hr. Rec. 15' vsocm 0#DST 3833-46 open 1 hr. Rec. 20'mud 0# B KC 3864 Marm. 3969TD 3998D & A

FABEN GILSTRAP