


Graham

DX 78-1

Section 21 Township 10 Range 23W **KANSAS**
Well No. #1 Trexler "A"
Company C R A

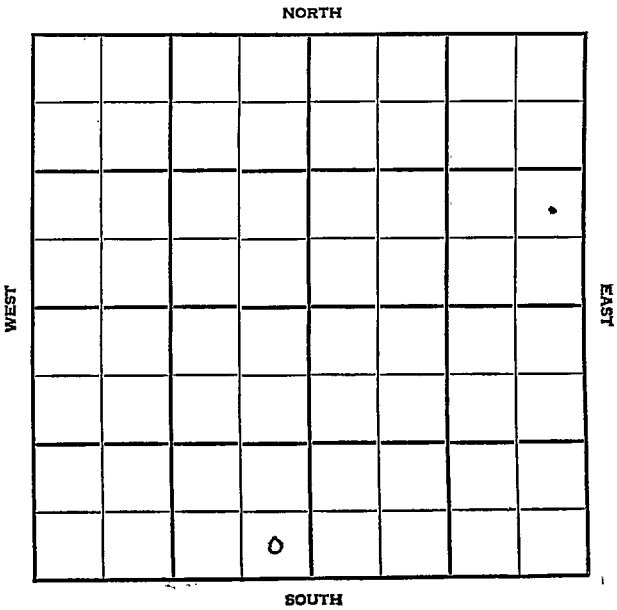

NOT FILE

Graham

KANSAS

SEC.	TWP.	R.
21	10	23 W

WELL NO.

1 Trexler "A" FARM

COMPANY

C R A

CONTRACTOR

C R A


Happy Pool
Ft. from N. Line

330 Ft. from S. Line

330 Ft. from E. Line

Ft. from W. Line

SE SE SW

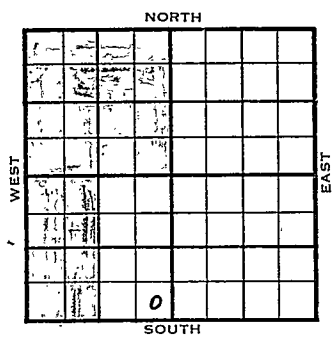

	ELEVATION	REPORT
1954	2377'	
5/5	Location	
5/6	"	(Ltr-McGehee)
5/13	"	"
5/20	"	"
5/27	"	"
6/3	Spud 5-26-54 10" @ 235 w/175 sax. Heeb 3592' or. 3612' Lans 3627' Drlg. 3700' (Ltr-McGehee)	
6/10	DST 3711-22, open 1 hr, rec 1560' gas, 270' GCO, 360' GCO & wtr., 450' wtr, 1200# DST-3790-3801, open 1 hr rec 15' VSOCM off DST 3809-21 open 1 hr gas in 45 min, rec 1000' GCO, 1100# DST 3826-41, open 1/2 hr rec 8' SOCM off RTD 3883 5" @ 3883. (Ltr-McGehee)	
6/25	CO to 3853 39/3811-24 FU 1095' oil in 3 hr. S/16 BO 1 hr. S/43 BO 6 hr. 3000 A F/23-3/4 BO 3 hr. Died. S/11 1/2 BOPH 7 hr., POP (Ltr-McGehee)	
6/30	NR	

OVER

1954

7/8

Completed for 858 BOPD (Ltr-McGahee)

7/7

Spud 5-26-54

Oil Well

TD 3883'

10" @ 235'

Heeb 3593', Tor 3612', Lans 3627'

DST 3711-22, opn 1 hr., rec. 1560'

gas, 270' gco, 360' gco & wtr., 450' wtr, 1200#

DST 3790-3801', opn 1 hr., rec. 15' svocm, 0#

DST 3809-21', opn 1 hr., gas in 45", rec. 1000' gco, 1100#

DST 3826-41', opn 1/2 hrs., rec. 8' socm, 0#

TD 3883'

5" @ 3883'

CO to 3853

39/3811-24, FU 1095' oil, 3 hrs.

S/16 bo 1 hrs., S/43 bo 6 hrs., 3000A


F/23 3/4 bo 3 hrs., died

S/11 $\frac{1}{2}$ boph 7 hrs.

Comp. 858 bopd

COMPLETED

J. G. McGEHEE

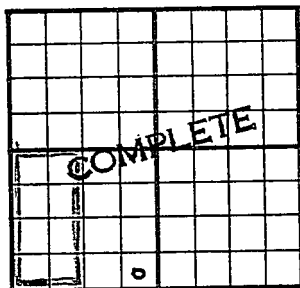County Graham State KansasSec. 21 (Blk. 10) (Sur. 2 3W) (Twp.) 10 Map No.Operator C R AWell No. 1 Farm Trexler "A"Elev. 2377 Location SE SE SW330 Ft. From S Line SW330 Ft. From E Line Quarter

1st. Report

Completion JUL 7 1954Remarks Happy PoolC R A - Contr.Spudding Date 5-26-54Drig. Data Oil well TD 388310" @ 235 Heeb. 3593 Tor. 3612Lans. 3627 DST 3711-22 open 1 hr.Rec. 1560' gas 270' gco 360' gco & wtr.450' wtr. 1200# DST 3790-3801 open 1 hrRec. 15' vsocm 0# DST 3809-21open 1 hr. gas in 45 min. Rec. 1000' gco1100# DST 3826-41 open $\frac{1}{2}$ hr. Rec. 8'socm 0# TD 3883 5" @ 3883 CO to3853 39/ 3811-24 FU 1095' oil 3 hr.S/ 16 bo 1 hr. S/ 43 bo 6 hr. 3000 AF/ 23 $\frac{3}{4}$ bo 3 hr. died S/ $11\frac{1}{2}$ boph 7 hrComp. 858 bopd

J. G. McGEHEE