


DX 78-1

Graham KANSAS

Section 21 Township 10 Range 23 ^W

Well No. # 6 C. Brown

Company Mid-Continent Petr. Corp.

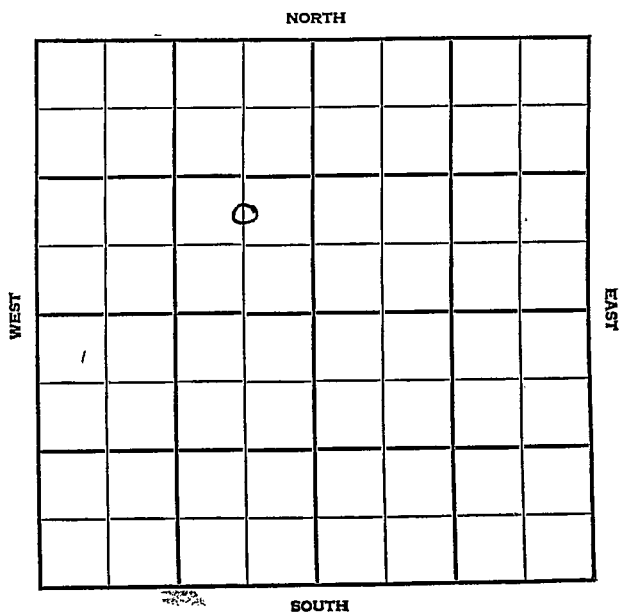

HOT FILE Graham KANSAS

SEC.	TWP.	R.
21	10 S	23 W


WELL NO.

6 Celestin Brown FARM

COMPANY

Mid-Cont. Petr. Corp.


CONTRACTOR

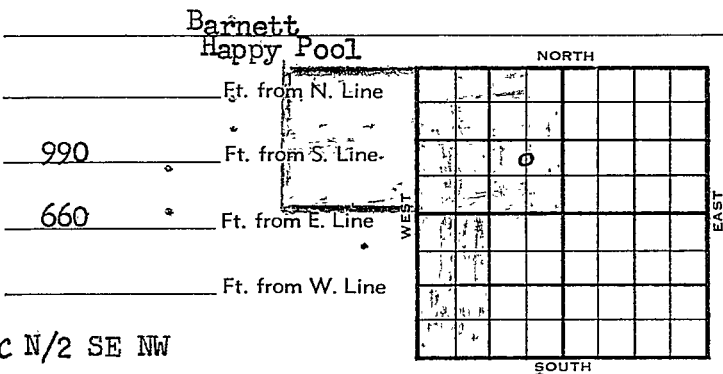

	ELEVATION	REPORT	
1954	2376'		
8/5	Location Notice		
8/5	Location		(DR)
8/6	MIR		"
8/9	TD 2000' Spud 8-6-54		"
	10-3/4" @ 243 w/150 sax.		"
8/10	Drlg. 2300'		"
8/11	Drlg. 2690' (F.R. Ticket)		"
8/12	Drlg. 2960'		"
8/13	Drlg. 3170'		"
8/16	Drlg. 3760'		"
8/17	Drlg. 3890'		"
8/18	TD 3890' Running casing.		"
8/19	TD 3890' 7" @ 3889 w/175 sax.		"
8/20	TD 3890' WOC		"
8/23	TD 3890' MI cable tools.		"
8/24	TD 3890' RUCT		"
8/25	TD 3890' Drlg. plugs		"
8/26	TD 3890' Perforating.		"
8/27	TD 3890'. Perf 24 holes 3810-14,		"
	60 holes 3823-33. Filled up 150'		"
	w/oil in 1 hr.		"
8/30	TD 3890'. Swabbing 20 BPH		"
	Potential will be taken 9-13-54.		"
	Setting pumping unit.		"

1954			
8/31	TD 3890'	Setting pumping unit.	(DR)
9/1	TD 3890'	Setting pumping unit.	"
9/2	TD 3890'	WO potential.	"
9/3	TD 3890'	WO potential	"
9/7	TD 3890'	WO potential.	"
9/8	TD 3890'	WO potential.	"
9/9	TD 3890'	WO potential.	"
9/10	TD 3890'	WO potential.	"
9/13	TD 3890'	Taking potential.	"
9/14	TD 3890'	Taking potential.	"
9/15	TD 3890'	Comp. 9-14-54	"
	Potential:	559 bbls per day	
9/15	Spud 8-6-54	Oil well TD 3890	
	10-3/4" @ 243	Heeb 3609	
	For. 3628	Lans 3648 TD 3890	
	7" @ 3889	24/3810-14 60/3823-33	
	FU 150' oil 1 hr.	3000 A	
	S/22 BOPH 14 hr.	Comp. 559 BOPD	


COMPLETED

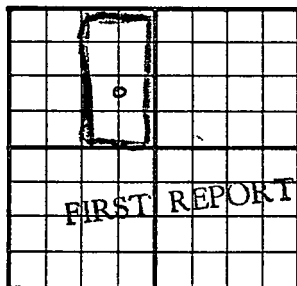County Graham State KansasSec. 21 (Blk. Twp.) 10 (Sur. Rge.) 23W Map No.Operator Mid-Continent Petroleum Corp.Well No. 6 Farm C. BrownElev. Location C N $\frac{1}{2}$ SE NW990 Ft. From S Line NW660 Ft. From E Line Quarter1st. Report AUG 11 1954

Completion

Remarks

Barnett Drlg. - Contr.Spudding Date 8-6-54Drlg. Data Happy Pool10 3/4" @ 243 drlg. 2690

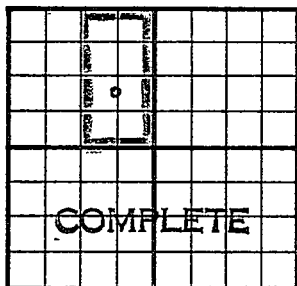
County Graham State KansasSec. 21 (Blk. 10 (Sur. 23W Map No.
(Twp.) (Rge.)Operator Mid-Continent Petroleum Corp.Well No. 6 Farm C. BrownElev. 2376 Location C N $\frac{1}{2}$ SE NW990 Ft. From S Line NW660 Ft. From E Line Quarter1st. ReportCompletion SEP 15 1954Remarks Happy Pool
Barnett Drlg. - ContrSpudding Date 8-6-54Drlg. Data Oil well TD 389010 3/4" @ 243 Heeb. 3609 Tor.3628 Lans. 3648 TD 3890 7" @3889 24/ 3810-14 60/ 3823-33FU 150' oil 1 hr. 3000 AS/ 22 boph 14 hr. Comp. 559 bopd

FABEN GILSTRAP

LOCATION NOTICE

TULSA, OKLA., 8-5-54WELL NO. 6 ON Celestin Brown FARM

WILL BE AS FOLLOWS:

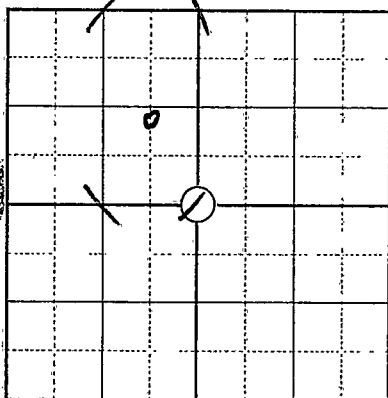

_____ FEET FROM NORTH LINE
660'
 _____ FEET FROM EAST LINE
990'
 _____ FEET FROM SOUTH LINE
 _____ FEET FROM WEST LINE
 IN E/2 NW/4

SEC. 21 TWP. 10S RANGE 23W

GrahamCOUNTY, STATE OF KansasREMARKS: R. L. Nankey; R. O. HobeyM.C.P.C. -- 100%

COPIES TO:

R. W. McDOWELL

DISTRICT SUPT.

ACCOUNTING DEPT.

✓ SCOUTING DEPT.

GEOLOGICAL DEPT.

PIPE LINE DEPT.

MATERIALS DEPT.

RENTAL DEPT.

LEGAL DEPT.

LEO MEYER

INCOME TAX DEPT.

ENGINEERING DEPT.

LEASE INVENTORY

CLAIM DEPT.

J. W. BASORE

FILE

SIGNED A. E. Pierce

Drig. Contractor:

Barnett Drilling Company*Card Typed - mm*