

Graham

DX 78-1


KANSAS

Section 21 Township 10 Range 23W

Well No. #1 Nick Brown

Company Mid-Continent Petroleum

NORTH

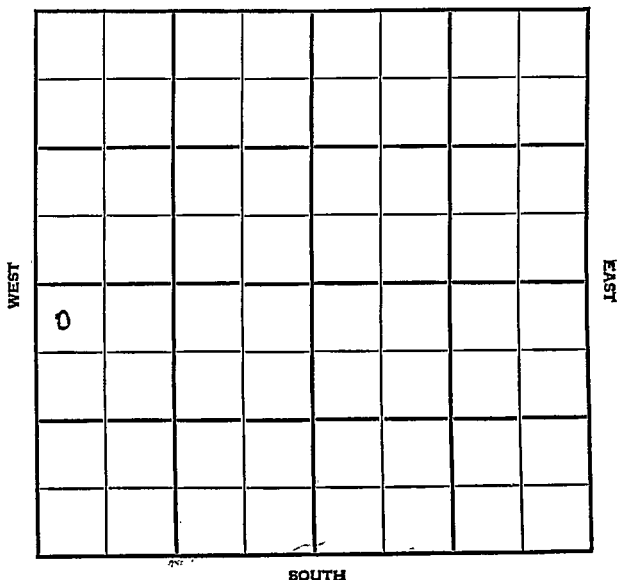


SEC. 21 TWP. 10 S R. 23 W ✓

WELL NO. # 1 Nick Brown FARM COMPANY

Mid-Continent Petroleum Corp.

CONTRACTOR Gabbert-Jones Happy Pool

330 Ft. from N. Line
 Ft. from S. Line
 Ft. from E. Line
 330 Ft. from W. Line

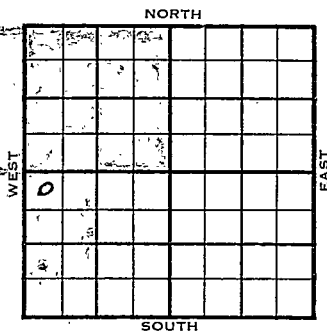


W $\frac{1}{2}$ -SW $\frac{1}{4}$ NW NW SW

1954	ELEVATION 2395' 2397' KB REPORT
5/3	Location Notice
5/3	Location (DR)
5/4	" "
5/5	Moving in rotary tools (F.R. Ticket)
5/6	TD 223' Spudded 5-5-54
	8-5/8" @ 223 w/175 sax. (DR)
5/7	Drlg. 611' "
5/10	Drlg. 3171' "
5/10	Spud 5-5-54 8-5/8" @ 223
	Drlg. 3171' (Wire)
5/11	Drlg. 3320' (DR)
5/12	TD 3730'. Tops: Heebner 3622'
	Toronto 3640' Lansing 3657' "
5/13	Top Heebner 3622' Top Toronto 3640'
	Top Lansing 3657'
	Took DST 3817-33, open 1 hr rec 620'
	oil and 60' oil cut mud. IPFP 35#
	FFP 255# BHP 1290# in 20 mins.
	To drill ahead to 2nd Break in
	Lansing approximately 20' deeper
	and take another DST. (Tel-McGehee)
5/14	TD 3897'. Rng csg.
	DST #2 3840-50, open 1 hr, rec 600'
	oil. BHP 1325# (DR)

1954			
5/17	TD 3897'.	5 $\frac{1}{2}$ " @ 3896 w/175 sax.	(DR)
	WOC.		
5/18	TD 3897'	Moving in cable tools.	"
5/19	TD 3897'	MICT.	"
5/20	TD 3897'	Drilling plugs.	"
5/21		Perforating @ 3897'	"
5/24	TD 3897'.	Acid Testing.	"
5/25	TD 3897'	Testing.	"
5/26	TD 3897'	Testing.	"
5/27	TD 3897'	No report.	"
5/27	36/3824-30	54/3840-49 S/14 BOPH	
	for 3 hr.,	3000 A, F/108 BO in 4 hr.	
	thru tubing.	(Ltr-McGehee)	
5/28	TD 3897'	Taking Potential.	(DR)
6/1	TD 3897'.	COMP. 5-31-54	
	Maximum well.	Allowable 48 BPD.	"
6/3	Completed for a state test of		
	3824 BOPD.	(Ltr-McGehee)	
6/2	Spud 5-5-54		
	Oil Well		
	TD 3897'		
	8" @ 223'		
	Heeb 3622',	Tor 3640',	Lans 3657'
	DST 3817-33',	opn 1 hr.,	rec. 620'
	oil, 60' ocm,	1290#	
	DST 3833-67',	opn 1 hr.,	rec. 600' oil,
	1325#		
	TD 3897'		
	5" @ 3897'		
	CO to TD		
	36/3824-30',	54/3840-49,	
	S/14 boph 3 hrs.,	3000A	
	F/108 bo 4 hrs.		
	Comp. 3000 bopd		
	BHB 3824 bopd		

COMPLETED

County Graham State Kansas
 Sec. 21 (Blk.) 10 (Sur.) 23W Map No.
 (Twp.) (Rge.)
 Operator Mid-Continent Petroleum
 Well No. 1 Farm Nick Brown
 Elev. Location NE NW SW

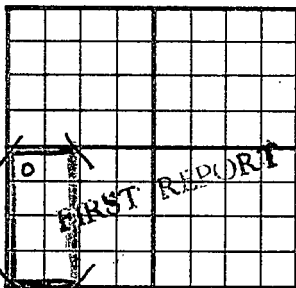

330 Ft. From N Line SW
330 Ft. From W Line Quarter
MAY 5 1954
 1st. Report

Completion

Remarks

Gabbert-Jones - Contr.


Spudding Date

Drilg. Data

Happy Pool

M I R

J. G. McGEHEE

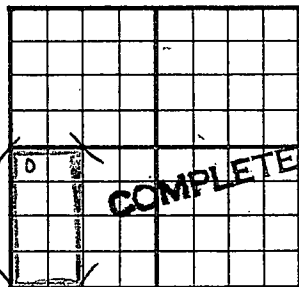County Graham State KansasSec. 21 (Blk. 10) (Sur. 23W) (Rge.) Map No.Operator Mid-Continent PetroleumWell No. 1 Farm Nick BrownElev. 2395 Location NW NW SW330 Ft. From N Line SW330 Ft. From W Line Quarter

1st. Report


Completion JUN 2 1954Remarks Happy PoolGabbert-Jones - Contr.Spudding Date 5-5-54Drlg. Data Oil well TD 38978" @ 223 Heeb. 3622 Tor. 3640Lans. 3657 DST 3817-33 open 1 hr.Rec. 620' oil 60' ocm 1290#DST 3833-67 open 1 hr. Rec. 600' oil1325# TD 3897 5" @ 3897 CO to TD36/ 3824-30 54/ 3840-49 S/ 14 boph 3 hr.3000 A F/ 108 bo 4 hr. Comp. 3000 bopdBHB 3824 bopd

J. G. McGEHEE

LOCATION NOTICE

TULSA, OKLA., May 3, 1954WELL NO. 1 ON Nick Brown FARM

WILL BE AS FOLLOWS:

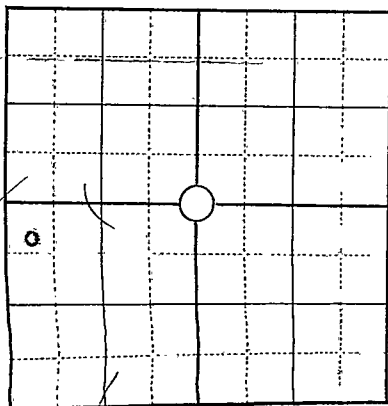330

FEET FROM NORTH LINE

FEET FROM EAST LINE

FEET FROM SOUTH LINE

330

FEET FROM WEST LINE

IN W/2 SW/4SEC. 21 TWP. 10S RANGE 23WGrahamCOUNTY, STATE OF KansasREMARKS: R. L. Mankey; R. O. BobeyM. C. P. C. ----- 100%

COPIES TO:

R. W. McDOWELL
DISTRICT SUPT.

ACCOUNTING DEPT.

SCOUTING DEPT.

GEOLOGICAL DEPT.

PIPE LINE DEPT.

MATERIALS DEPT.

RENTAL DEPT.

LEGAL DEPT.

LEO MEYER

INCOME TAX DEPT.

ENGINEERING DEPT.

LEASE INVENTORY

CLAIM DEPT.

J. W. BASORE

FILE

SIGNED

A. E. Pierce*Card Typed - MM**in first report drawer*