


Section 21 Township 10 Range 23 W
Well No. # 5 C. Brown
Company Mid-Continent Petr. Corp.

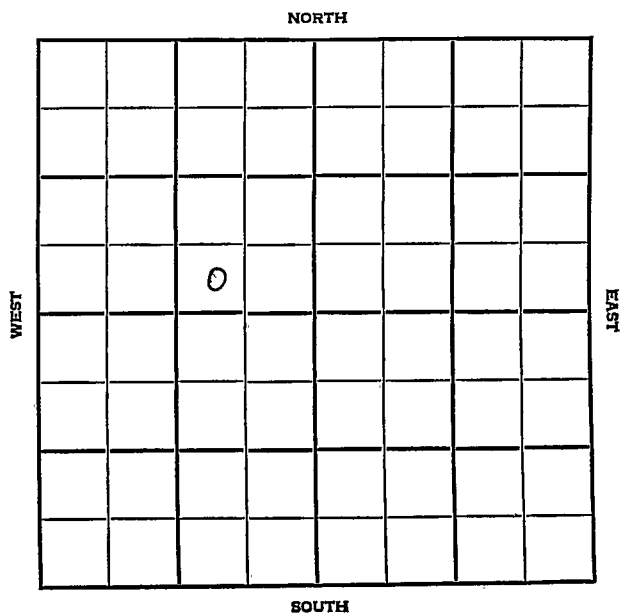

HOT FILE Graham KANSAS

SEC#	TWP.	R.
21	10 S	23 W
WELL NO.		
# 5 Celestin Brown		FARM
COMPANY		

Mid-Continent Petroleum Corp.

CONTRACTOR

Barnett
~~Gabbert Jones~~

Happy Pool

Ft. from N. Line

330

Ft. from S. Line


990

Ft. from E. Line

-330

Ft. from W. Line

SW SE NW

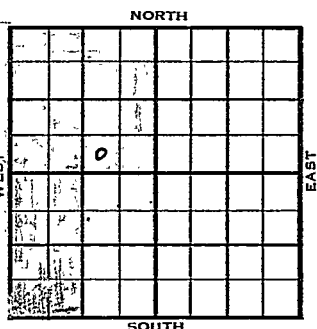

ELEVATION


REPORT

1954	2379 L+5	
7/24	Location Notice	
7/26	Spud 7-24-54	
	10-3/4" @ 238 w/150 sks.	
	Drlg. 700'	(DR)
7/27	Drlg. 1970'	"
7/28	Drlg. 2385'	"
7/29	Drlg. 2685' (F.R. Ticket)	"
7/30	Drlg. 2960'	"
8/2	Drlg. 3640'	"
8/3	Drlg. 3761' Heeb 3604', Tor	"
8/4	Drlg. 3828' 3623', Lans 3644'	"
8/5	TD 3893' Running casing.	
	DST 3818-44, open 30", rec 1580' oil.	"
8/6	TD 3893' 7" @ 3892 w/175 sks.	"
8/9	TD 3893' MT cable tools.	"
8/10	TD 3893' Drilling plugs.	"
8/11	TD 3893' Drilling plugs.	"
8/12	TD 3893' Perf 3802-6 3820-30	
	Running tubing to acidize.	"
8/13	TD 3893' Acidized w/3000 gallons	
	Testing.	"
8/16	TD 3893' Testing.	"
8/17	TD 3893' Testing.	"

1954
 8/18 TD 3893' WO potential. (DR)
 8/19 TD 3893' Waking potential. "
 8/20 TD 3893' Taking potential. "
 8/23 TD 3893' COMP. 8-21-54
 1938 bbls per day, potential. "
 8/25 Spud 7-24-54
 Oil Well
 TD 3893'
 10" @ 238'
 Heeb 3604', Tor 3623', ⁴ans 3644'
 DST 3818-34, opn $\frac{1}{2}$ hrs., rec. 1580'
 oil, 120' o & gcm, 925#
 TD 3893'
 7" @ 3892'
 CO to 3882'
 24/3802-06, 60/3820-30, 3000 A
 S/30 boph
 C omp. BHB 1938 bopd

COMPLETED

County Graham State Kansas
 (Blk.) (Sur.)
 Sec. 21 (Twp.) 10 (Rge.) 23W Map No.
 Operator Mid-Continent Pet. Corp.
 Well No. 5 Farm C. Brown
 Elev. 2379 Location SW SE NW

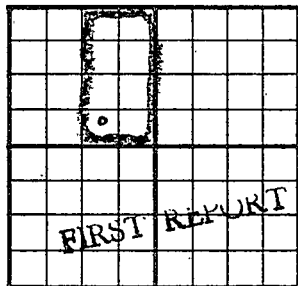


330 Ft. From S Line NW
990 Ft. From E Line Quarter
 Ist. Report JUL 28 1954
 Completion
 Remarks
Barnett - Contr.
 Spudding Date 7-24-54

Drlg. Data Happy Pool
10" @ 238 drlg. 1970 Ø 2685

J. G. McGEHEE

County Graham State Kansas
 Sec. 21 (Blk. 10 (Sur. 23W Map No.)
 (Twp.) (Rge.)
 Operator Mid-Continent Petroleum Corp.
 Well No. 5 Farm C. Brown
 Elev. 2379 Location SW SE NW

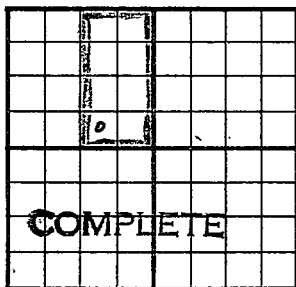

330 Ft. From S Line NW
990 Ft. From E Line Quarter

1st. Report

Completion AUG 25 1954

Remarks Happy Pool
Barnett - Contr.

Spudding Date 7-24-54

Drilg. Data Oil well TD 3893

10" @ 238 Heeb. 3604 Tor. 3623

Lans. 3644 DST 3818-34 open $\frac{1}{2}$ hr.

Rec. 1580' oil 120' o & gcm 925#

TD 3893 7" @ 3892 CO to 3882

24/ 3802-06 60/ 3820-30 3000 A


S/ 30 boph Comp. BHB 1938 bopd

FABEN GILSTRAP

LOCATION NOTICE

TULSA, OKLA., July 24, 1954WELL NO. 5 ON Celestin Brown FARM

WILL BE AS FOLLOWS:

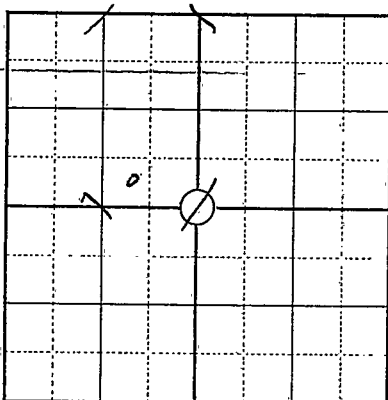

_____ FEET FROM NORTH LINE

_____ FEET FROM EAST LINE

330

_____ FEET FROM SOUTH LINE

330

_____ FEET FROM WEST LINE

IN E/2 NW/4 Sec. 21 (Also E/2 NE/4 Sec. 20)SEC. 21TWP. 10SRANGE 23WGraham

COUNTY, STATE OF

KansasREMARKS: R. L. Mankey; R. O. BobeyM.C.P.G. — 100%

COPIES TO:

R. W. McDOWELL
 DISTRICT SUPT.
 ACCOUNTING DEPT.
 SCOUTING DEPT.
 GEOLOGICAL DEPT.
 PIPE LINE DEPT.
 MATERIALS DEPT.
 RENTAL DEPT.
 LEGAL DEPT.
 LEO MEYER
 INCOME TAX DEPT.
 ENGINEERING DEPT.
 LEASE INVENTORY
 CLAIM DEPT.
 J. W. BASORE
 FILE

SIGNED _____

A. E. Pierce

Card Typed - MM