

Loc. Notice


FORM 51

Graham KANSAS

Section 21 Township 10 Range 23 W

Well No. # 3 Nick Brown

Company Mid-Continent Petr.

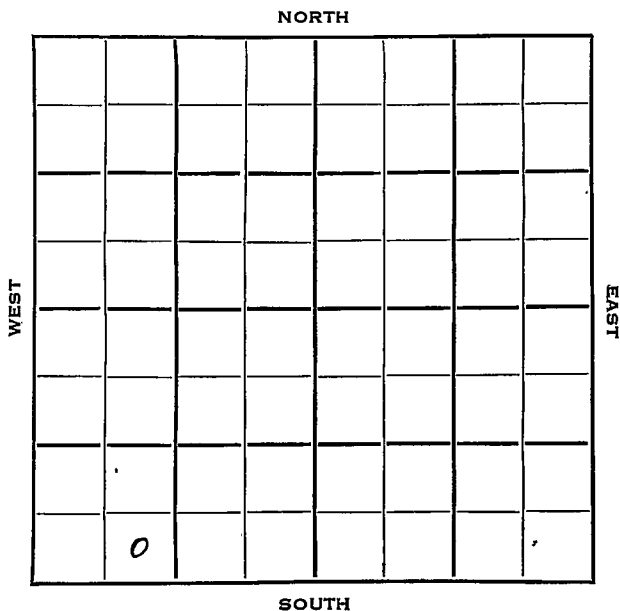

HOT FILE

Graham

KANSAS

SEC.

TWP.

R.

21

10 S

23 W

WELL NO.

3 Nick Brown

FARM

COMPANY

Mid-Continent Petr. Corp.

CONTRACTOR

Gabbert-Jones .

Happy Pool

NORTH

Ft. from N. Line

330

Ft. from S. Line

-330-

Ft. from E. Line

990

Ft. from W. Line

SE SW SW

SOUTH

ELEVATION

REPORT

1954

2391' DF

6/5

Location Notice

6/7

Spud 6-5-54

8-5/8" @ 253 w/150 sax.

Drlg. 1990'

(DR)

6/8

TD 1990' No report

"

6/9

Drlg. 3075' (F.R. Ticket)

"

6/10

Drlg. 3300'

"

6/11

Drlg. 3652'

"

6/14

TD 3891'

5 1/2" @ 3890 w/175 sax.

"

6/15

TD 3891' MICT

"

6/16

TD 3891' MICT

"

6/17

TD 3891' MICT (Delayed by rain.)

"

6/18

TD 3891' Bailed out mud.

Preparing to drill cement.

"

6/21

TD 3891'. Perf 3860-68; 3833-43;
3818-26. Acidized w/3000 gal.

"

6/22

TD 3891' Testing.

"

6/23

TD 3891' Testing.

"

6/24

TD 3891' Testing.

"

6/25

TD 3891' WO potential.

"

6/25

CO to 3889. 22/3860-68 60/3833-43

48/3818-26 FU 2500' oil in 1 1/2 hr.

3000 A S/23 BOPH for 3 hr. Waiting

on potential.

(Ltr-McGehee)

DX-78

OVER

1954		
6/28	TD 3891' WO potential.	(DR)
6/28	TD 3891' WO potential.	"
6/30	TD 3891' Taking potential.	"
7/1	TD 3891' COMP. 6-30-54 Minimum oil well. Allowable: 30 BPD on pump.	"
7/8	Completed for 2203 BOPD plus 10% water. (Ltr-McGehee)	
7/7	Spud 6-5-54 Oil Well TD 3891' 8" @ 253' Heeb 3612', Tor 3632', Lans 3645' TD 3891' 5" @ 3890' CO to 3889' 22/3860-68, 60/3833-43, 48/3818-26 FU 2500' oil, 1½ hrs., 300QA S/232 bo 47 bw S/114 bo 114 bw S/23 boph 3 hrs. Comp. BHB 2203 bopd + 10% wtr.	

COMPLETED

County Graham State Kansas

Sec. **21** (Blk. Twp.) **10** (Sur. Rge.) **23W** Map No.

Operator Mid-Continent P.t.

Well No. **3** Farm **Nick Brown**

Elev.	Location	SE	SW	SW
-------	----------	----	----	----

FIRST REPORT

330 Ft. From S Line SW

990 Ft. From ~~the~~ Line Quarter

1st. Report **JUN 9 1954**

Completion

Remarks

Gabbert-Jones - Contr.


Spudding Date 6-5-54

Drlg. Data Happy Pool

8th @ 253 drlg. 3075 63320

J. G. McGEHEE

County Graham State Kansas
 Sec. 21 (Blk.) 10 (Sur.) 23W Map No.
 Operator Mid-Continent Petroleum Corp.
 Well No. 3 Farm Nick Brown
 Elev. 2391 Location SE SW SW

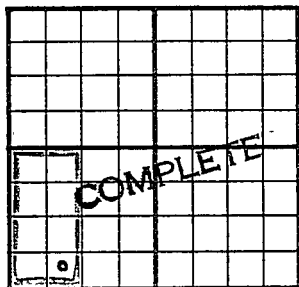


330 Ft. From S Line SW
990 Ft. From W Line Quarter
 1st. Report
 Completion JUL 7 1954
 Remarks Happy Pool
Gabbert-Jones - Contr.
 Spudding Date 6-5-54

Drilg. Data Oil well TD 3891
8" @ 253 Heeb. 3612 Tor. 3632
Lens. 3645 TD 3891 5" @ 3890
CO to 3889 22/ 3860-68 60/ 3833-43
48/ 3818-26 FU 2500' oil 1½ hr. 3000 A
S/ 232 bo 47 bw S/ 114 bo 14 bw
S/ 23 boph 3 hr. Comp. BHB 2203 bopd
plus 10% wtr.

LOCATION NOTICE

TULSA, OKLA., June 5, 1954WELL NO. 3 ON Nick Brown FARM

WILL BE AS FOLLOWS:

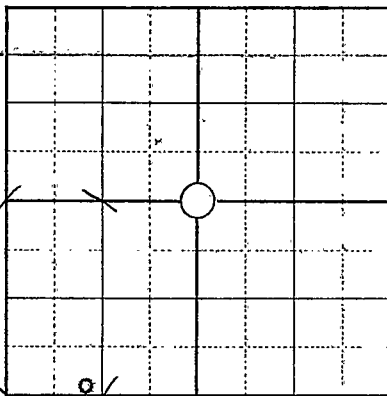

_____ FEET FROM NORTH LINE

330 FEET FROM EAST LINE330 FEET FROM SOUTH LINE

_____ FEET FROM WEST LINE

IN W/2 SW/4SEC. 21 TWP. 10S RANGE 23WGraham COUNTY, STATE OF KansasREMARKS: R.L. Mankey; R.O. RobeyM.C.P.C. — 100%

COPIES TO:

R. W. McDOWELL
 DISTRICT SUPT.
 ACCOUNTING DEPT.
 ✓ SCOUTING DEPT.
 GEOLOGICAL DEPT.
 PIPE LINE DEPT.
 MATERIALS DEPT.
 RENTAL DEPT.
 LEGAL DEPT.
 LEO MEYER
 INCOME TAX DEPT.
 ENGINEERING DEPT.
 LEASE INVENTORY
 CLAIM DEPT.
 J. W. BASORE
 FILE

SIGNED A. E. Pierce

W

Card-MTM