


SECTION 21 TOWNSHIP 10S RANGE 26W

WELL NO. #1 Phelps

COMPANY Leben Drlg.

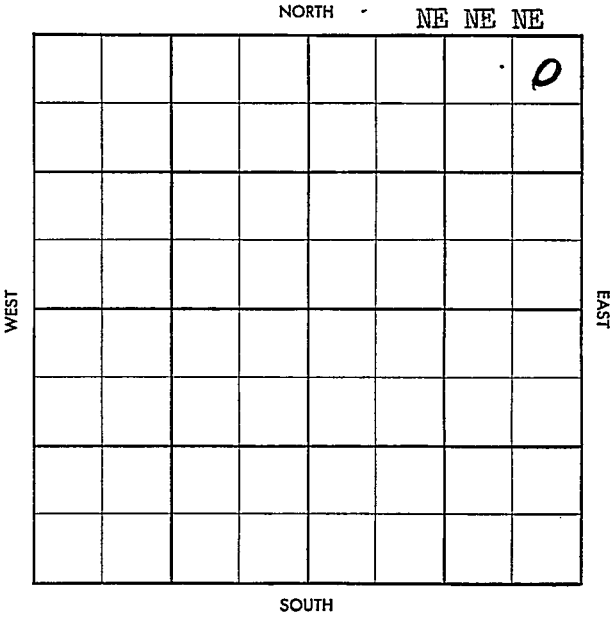

33

WILDCAT

S-513-B

County Sheridan Elev. _____
 Sec. 21 Twp. 10 Rge. 26W
 Company Leben Drlg.
 Farm Name Phelps No. 1

TOPS	DEPTH	LOG	DATUM
Anh.	2205		
Tp.			
H.			
Tr.			
Dg.			
B.L.			
L.			
K.C.			
B.K.C.			
Ce.			
C.			
M.			
M.			
K.			
Mz.			
Mq.			
V.			
S.			
S.			
A.			
R.			
Pf.			
G.			
T.D.			

Loc. in Sec. _____
NE NE NE
 Geol. _____
 Contr. _____
Co. Tools #1
 Pool _____
Wildcat

FIRST REPORT
FEB 12 1958

Date Comm. 2/7/58 (Gore - Support.)
 (Anderson, Prichard, Amerada
 8" @ 231 w/150, Drlg. 2330.)

Co.
 Use
 No.
 Sec.
 T.
 R.

5-313-a

County: Sheridan Elev: 25730 or 25760
 Sec: 21 Twp: 10 Rge: 26W
 Company: Leben Drlg.
 Farm Name: Philps No: 1

TOPS	DEPTH	LOG	DATUM
Anh.	2205		
Tp.	3587		
H.	3813	3812	
Jr.	3834	3832	
Dg.			
B.L.			
L.	3854	3847	
K.G.			
B.K.C.	4093	4091	
Ce.			
C.			
M.			
M.			
K.			
Mz.			
Mq.			
V.			
S.			
S.			
A.			
R.			
Pf.			
G.			
T.D.	4115	4116	

Loc. in Sec. NE NE NE
 Geol. Y
 Contr. Y
 Co. Tools #1
 Pool Wildcat
 FEB 26 '58
ABANDONED

Date Comm: 2/7/58 (Gore - Support.)
Anderson, Prichard, Amerada
8" @ 231 w/150, Drlg. 2330. FEB 19 '58
3884 - 3906 60" rec
13' tarty spk m BHP 0-205
FPO 3950 FEB 26 '58 109

D&A