

Section 21 Township 10 Range 16WWell No. #1 ZeiglerCompany Doley Oil

NORTH

WEST

EAST

SOUTH


4

Sec. 21 Twp. 10 R. 16WWell No. #1 Zeigler FarmDoley Oil Company

Wildcat

330 Ft. from N. Line Ft. from S. Line Ft. from E. Line330 Ft. from W. Line

NW/C

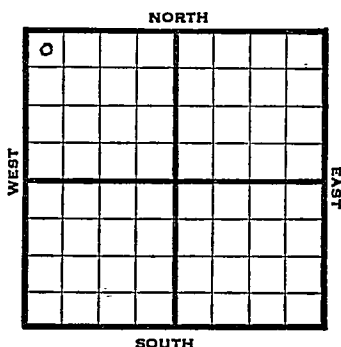

1948	Elev. 2080'	REPORT
1/28	Location	
2/4	"	
2/11	"	
2/18	"	
2/25	RUR	
3/3	12" @ 155'	
	Drlg. 2000'	
3/10	Drlg. 2665'	
3/17	2825' SD	
3/24	Topeka 2980'	
	Lansing 3257'	
	Drlg. 3285'	
3/31	Conglomerate 3575'	
	Arbuckle 3737'	
	TD 3780'	
	5" @ 3295'	
	WOC	
4/7	Arbuckle 3737'	
	Total Depth 3780'	
	ABANDONED	

Map No. _____ Sec. 21 Twp. 10 R. 16W

Well No. 1 Zeigler

Doley Oil

Company

FIRST REPORT

Contractor

NW/C


SECTION PLAT

330 Ft. from N. Line

_____ Ft. from S. Line

_____ Ft. from E. Line

330 Ft. from W. Line

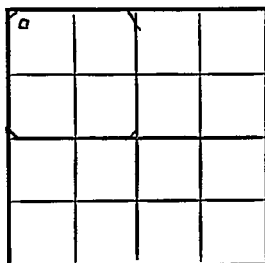

Rooks County

Location X

Rig up _____

Drilling and Remarks:

RECORD

Cased _____ in., _____ ft.

Sand _____

Gas _____

Oil _____

Total Depth _____

PRODUCTION

1st 24 hrs. Nat. _____

1st 24 hrs. after shot _____

Gas _____ Cu. Ft.

Dry Hole _____

Abandoned _____

Date

JAN 28 1948

19

J. J. LEWIS

Scout

Map No. 64 Sec. 21 Twp. 10 R. 16W

Well No. 1 Zeigler

Doley Oil Company

ABANDONED

Contractor

NW/C

E/ 2080

SECTION PLAT

330 Ft. from N. Line

 Ft. from S. Line

 Ft. from E. Line

330 Ft. from W. Line

0			

Rooks County

Location

Rig up

Drilling and Remarks:

OK 4323?

RECORD

Cased in., ft.

Sand

Gas

Oil

Total Depth 3280

PRODUCTION

1st 24 hrs. Nat.

1st 24 hrs. after shot

Gas Cu. Ft.

Dry Hole

Abandoned

Date

APR 7 1946

19

S. J. LEWIS

Scout