


Section 21 Township 10 Range 17-W

Well No. #1 Fee

Company V Thacher

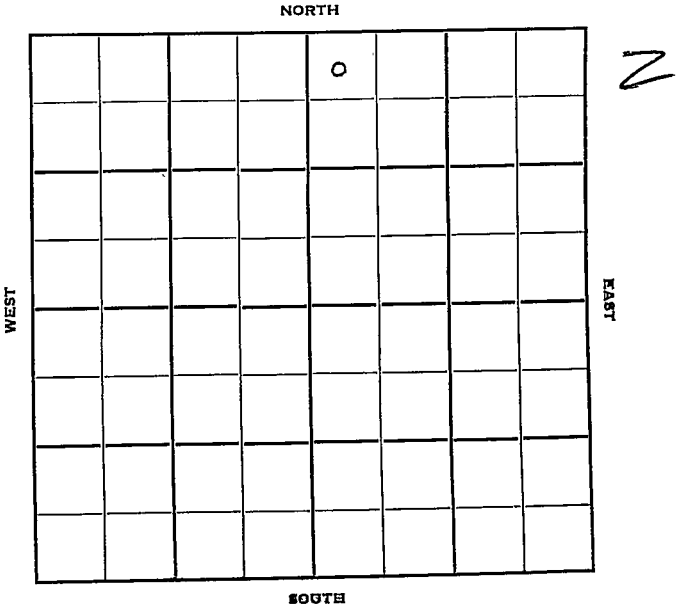

KANSAS

Rooks

Sec. 21 Twp. 10 R. 17-W

Well No. #1 Fee Farm

V Thacher Company

Contractor

Wildcat


330 Ft. from N. Line

 Ft. from S. Line

 Ft. from E. Line

330 Ft. from W. Line

NW NW NE

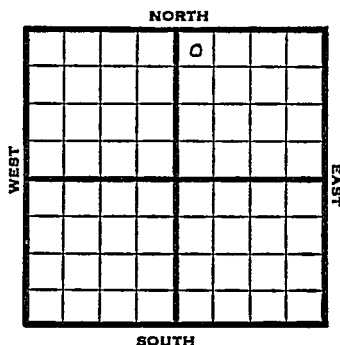

1950 Elev 2077 REPORT

8/2 Spud 7-16-50
8 5/8" @ 180
Anny 1340
Heeb 3260
Lans 3298
Simp 3673
TD 3715
D&A

Top 3059
Toronto 3287
Cong 3585
Arb 3694

FIRST REPORT

ABANDONED

Kansas


Wildcat

Map No. _____ Sec. 21 Twp. 10 R. 17WWell No. 1 FeeV. Thacher

Company

Contractor

NW NW NE

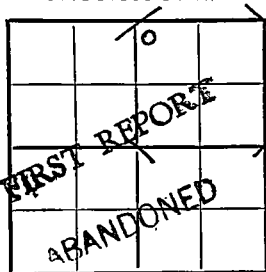El. 2077
SECTION PLAT330 Ft. from N. Line Ft. from S. Line Ft. from E. Line330 Ft. from W. Line

Rooks County

Location _____

Rig up _____

Drilling and Remarks:

Spud 7-16-50

8 5/8" @ 180

Anhy 1340

Top. 3059

Heeb. 3260

Toronto 3287

Lans. 3298

RECORD

Cased _____ in., _____ ft.

Sand _____

Gas _____

Oil _____

Total Depth 3715

PRODUCTION

1st 24 hrs. Nat. _____

1st 24 hrs. after shot _____

Gas _____ Cu. Ft.

Dry Hole _____

Abandoned _____

Date

AUG 2 1950

19

J. E. TYRA

Scout

Cong. 3585

Simp. 3673

Arb. 3694

TD 3715

D & A

AUG 7 1950

Scout Cards	7 W
Land Small Map	5
Land Wall Map	
Tracings	
France Map	
Pierce Map	
Misc.	

Aug 5 1950