

Rooks


KANSAS

SECTION 21 TOWNSHIP 10 RANGE 20 W

WELL NO. #1 Keller "B"

COMPANY C & G Drlg. & D. G. Hanson

NORTH

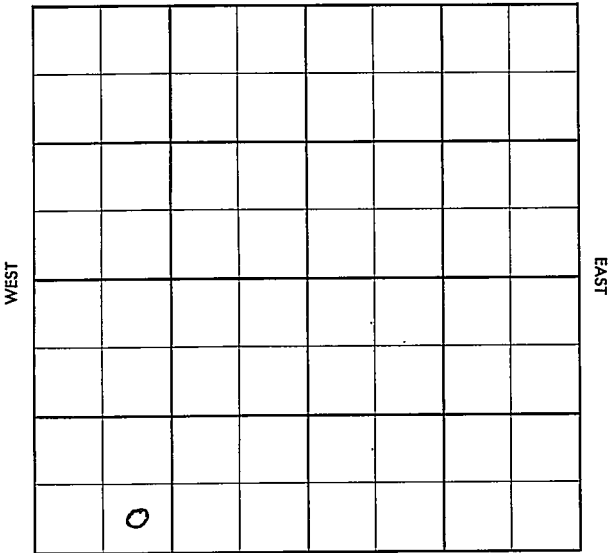

SOUTH

KANSAS

WELL NO.

#1 Keller "B"

FARM

COMPANY

C & G Drlg. & D.G. Hansen

CONTRACTOR

Co. Tools

Alphin


Ft. from N. Line

Ft. from S. Line

Ft. from E. Line

1100' Ft. from W. Line

SE SW SW

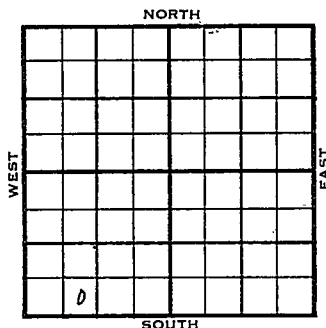

1955	ELEVATION 2208	REPORT
11-30	Comm. 11-25-55 8" @ 193/160 Drlg. 2510 Anh. 1676'	
12-7	DST 3797-3801 op 45 min. rec. 10' mud O# DST 3801-07 op 1 hr. rec. 20' mud, 270# D & A Tp. 3256 H. 3460 Tr. 3480 L. 3497 BKC 3720 C. 3751 S. 3777 A. 3796 TD 3822'	
ABANDONED		

DX-78

County Rooks Elev. _____
 Sec. 21 Twp. (10) Rge. 20W
 Company C. E. G. Drilg. & D. G. Hansen
 Farm Name Keller "B" No. 1

TOPS	DEPTH	LOG	DATUM	Loc. in Sec.
Anh.	1676			SE SW
Tr.				
H.				
Tr.				
Dg.				
Bl.				
L.				
K.C.				Geol.
B.K.C.				Contr.
Ce.				Co. tools
C.				
M.				Pool
M.				Allphin
K.				
Mz.				
Mq.				
V.				
S.				
S.				
A.				
R.				
Pe.				
G.				
T.D.				

Date Comm. 11-25-55
8" @ 193/160 drilg. 2510

NOV-30-55		
FIRST REPORT		

County Rooks Elev. 2208
 Sec. 21 Twp. 10 Rge. 20W
 Company C & G Drilling & D. G. Hansen
 Farm Name Keller "B" No. 1

TOPS	DEPTH	LOG	DATUM	Loc. in Sec.
Anb.	11676			SE SW SW
Top	3256		1048	
H.	3460		1252	1100' WL
Tr.	3480		1272	
Dg.				
BL.				
L.	3497		1289	Geol.
K.C.				
B.K.C.	3720		1512	Contr.
Ce.				
C.	3751		1543	Co. tools
M.				
M.				Pool
K.				
Mz.				Allphin
Me.				
V.				
S.	3777		1569	ABANDONED
S.				
A.	3796		1588	
R.				
Pe.				
G.				
TD.	3822			0

Date Comm. 11-25-55

DEC 7 1955

8" @ 193/160 DST 3797-3801 open 45 min

rec. 10' mud 0# DST 3801-07 open

1 hr. rec. 20' mud 270#

D & A